

Name

Service No.

Address # 20 Selamen Pierce Rd.

20 Selamen Pierce Rd.

Location

Kind of Pipe PVC

Size

6"

Size of Main 8" PVC

Repair—Renewal (New Service)

Location

Date

Material

Amount

Total

Date

Amount

5/2/86


① 6x4" Fernco reducer
60' 8" of 6" PVC
10' 0" " 4" "

DATE _____

TOWN OF LEXINGTON — BOARD OF PUBLIC WORKS
SEWER DIVISION

Sketch of Service Here

20

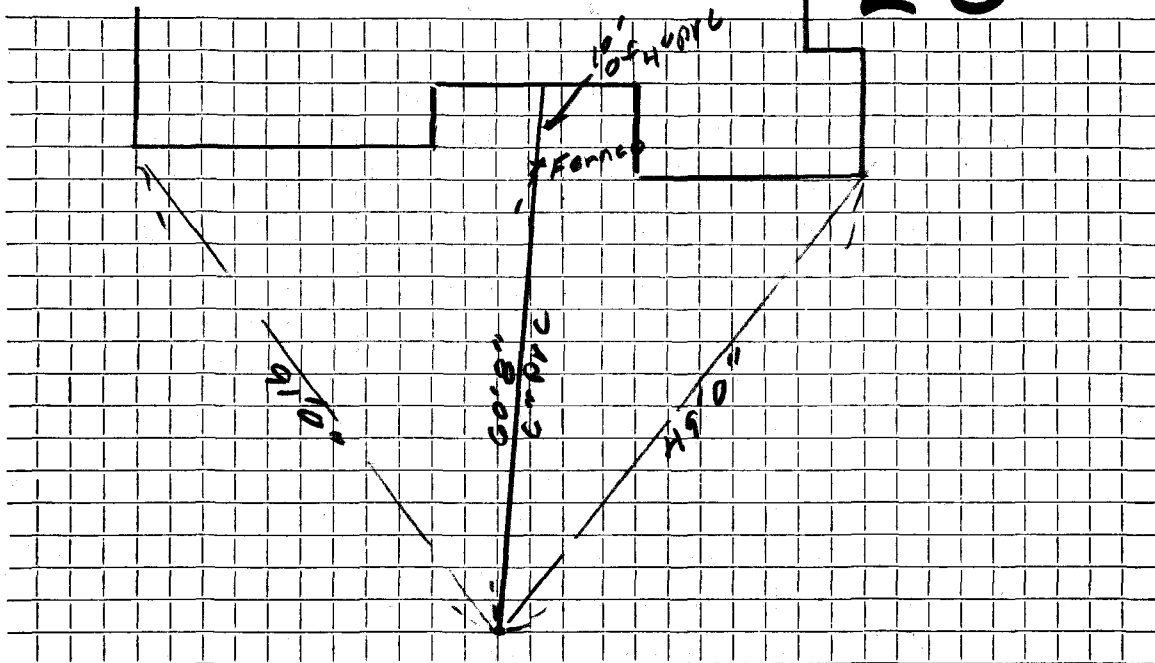

Connection made in Street. Work completed

Remarks:

.....