

DATE _____

TOWN OF LEXINGTON — BOARD OF PUBLIC WORKS


SEWER DIVISION

LOT # 47

Sketch of Service Here

21

421 Salem Pierle Rd

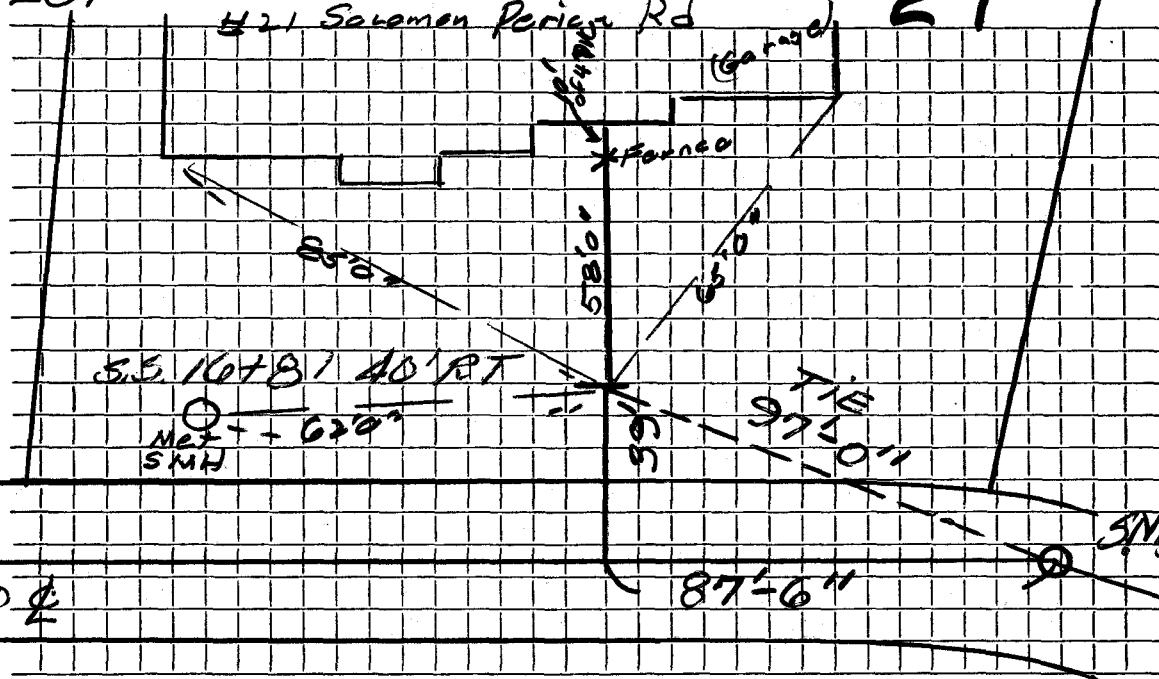

Connection made in SOLDMON PIERLE Street. Work completed

Remarks:
.....
.....