




DATE 10-30-90

TOWN OF LEXINGTON — BOARD OF PUBLIC WORKS  
SEWER DIVISION

Sketch of Service Here **22**

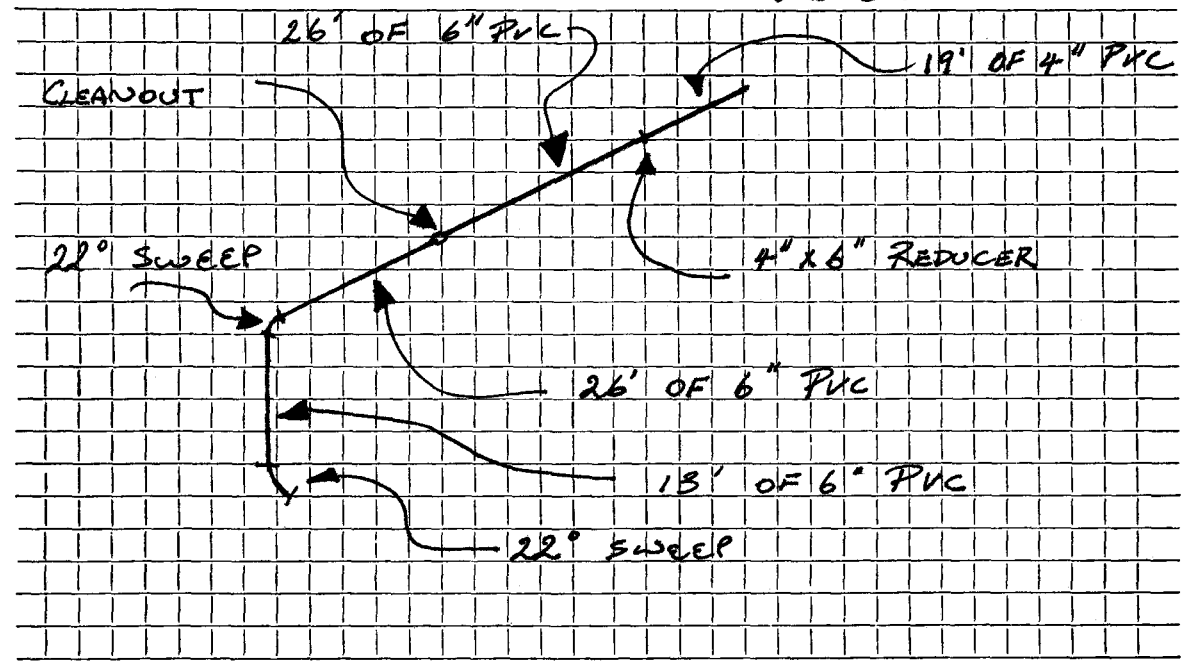

Connection made in Solomon Pierce Street. Work completed .....

Remarks: INSPECTED 8-12-87 BY CRG. INSTALLED BY J. McLAUGHLIN