


DATE _____

TOWN OF LEXINGTON — BOARD OF PUBLIC WORKS

SEWER DIVISION

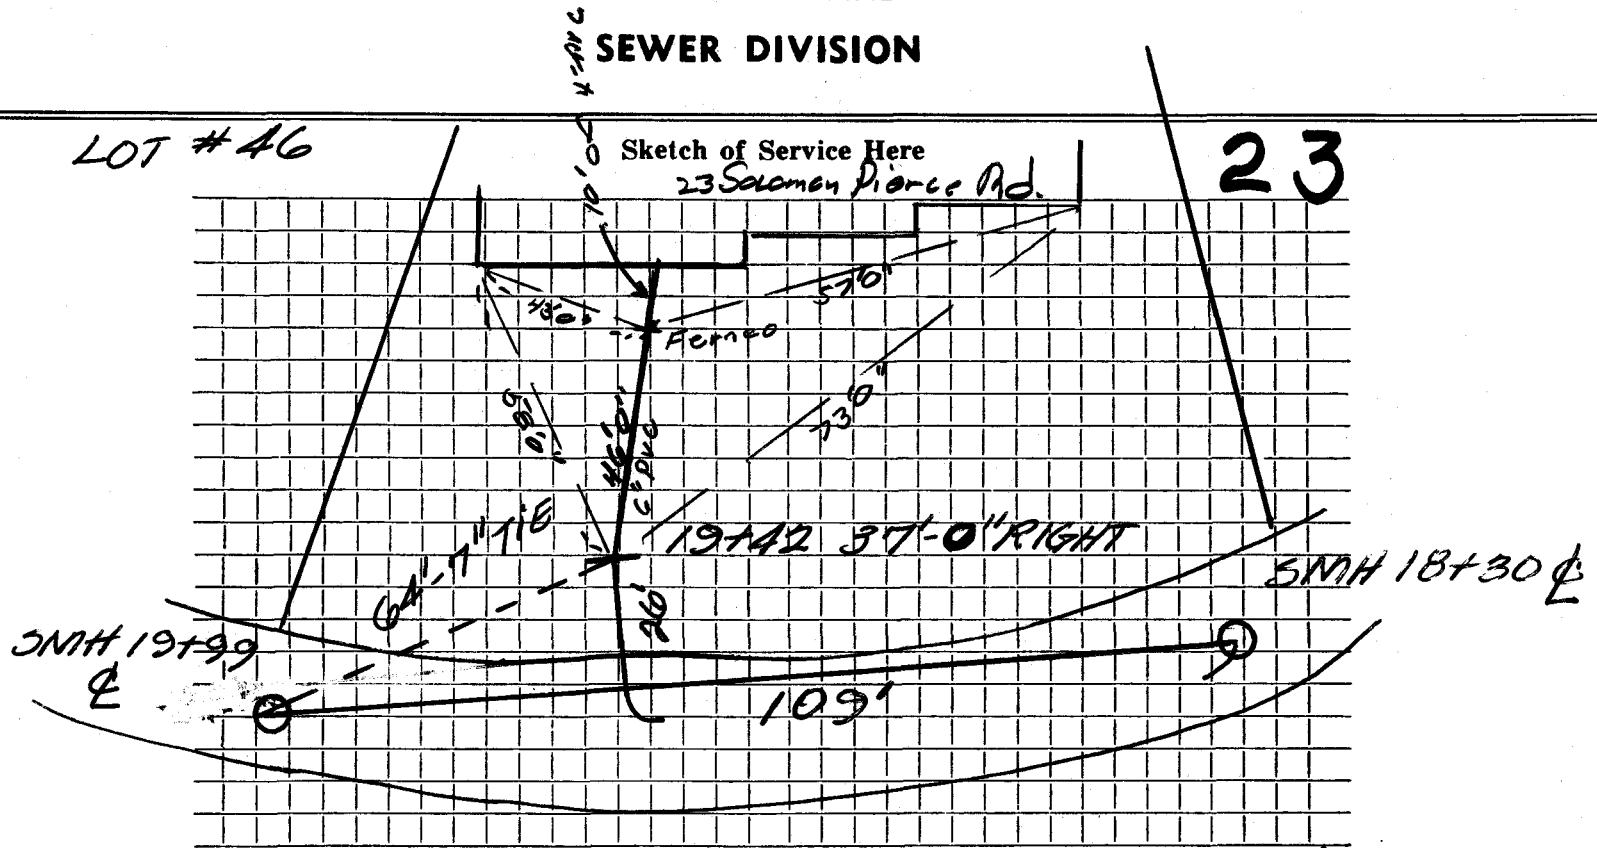

Connection made in SOLOMON PIERCE Street. Work completed 3/14/86

Remarks:
.....
.....