



Name

Currans

Service No.

Address

25 SOMERSET Road - 41 Hancock St.

25 Somerset Road

Location

Kind of Pipe

PVC

Size

6"

Size of Main

8"

Repair ~~Renewal~~ New Service

Santo Const. #0734

Location

Date

Material

Amount

Total

Date

Amount

11/27/95

46.5'-6" PVC

6-13-79

20' 6" Transite

1 6"-5' Nipple

1 6"-1' Nipple

1 6" x 90° Elbow

1 6" x 8" Wye

1979

120' 4" Sewer Pipe

1 1/8" Bend

1 10" x 6" Wyo

DATE 11/28/95.


TOWN OF LEXINGTON — BOARD OF PUBLIC WORKS  
SEWER DIVISION

↑ FRONT OF HOUSE.

Sketch of Service Here **25**

SERVICE COLLECTED TO HALICOCK ST.

HALICOCK STREET.

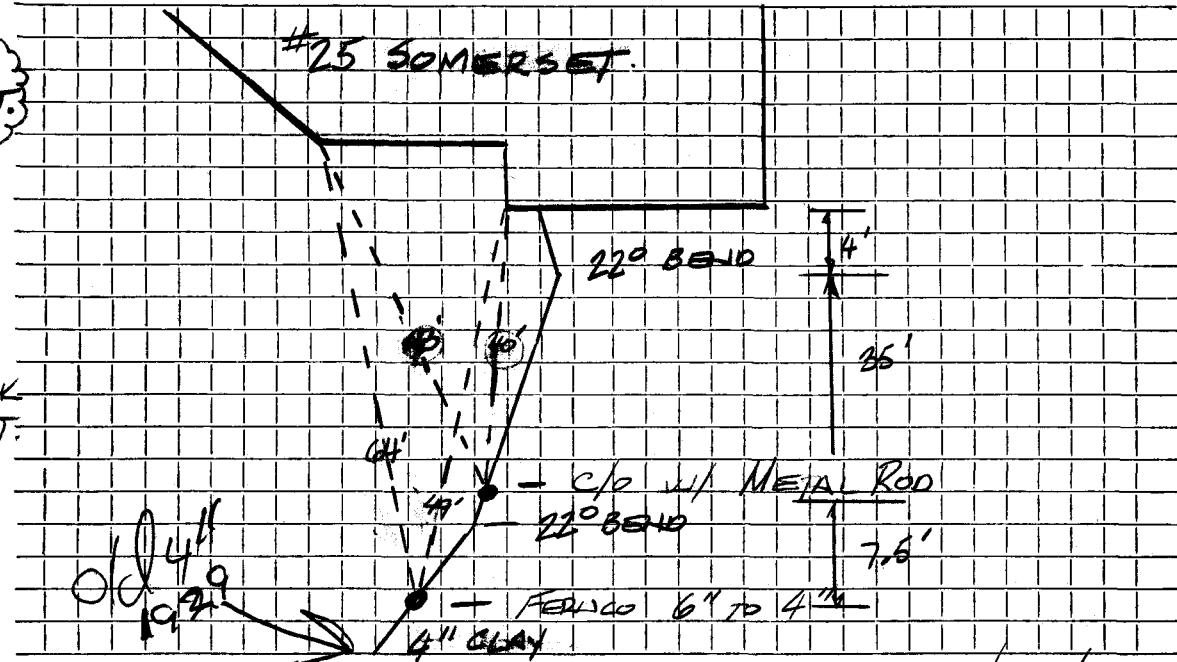

Connection made in 25 SOMERSET. Street. Work completed 11/28/95.

Remarks: COLLECTED TO HALICOCK ST.

CONTRACTOR - SANDS BROS.

INSPECTOR - T.F.H.

Name

41 Hancock St

Service No.

Address

25 Somerset Road for ~~35~~ Hancock Street

Location

Kind of Pipe

Size

Size of Main

Repair—Renewal—New Service

Location

Date

Material

Amount

Total

Date

Amount

1979

120 4" Sewer pipe

1 1/2 Bend

1 10x6 Y

Subsidiary and Jute

OUTSIDE W.O. #0508

6/13/14/79

Labor

2 6" X 10' Trans Pipe

1 6" X 5' Trans. Nipple

1 6" X 1' Trans nipple

1 6" X 90 Trans elbow

1 6" X 8" saddle

Patch Trench 30' X 8'

Patch Sidewalk 12' X 7'

6 1/2 Hrs. Trucking

4 Hrs. Case

1 1/2 Hrs. Roller

DATE \_\_\_\_\_

**TOWN OF LEXINGTON — BOARD OF PUBLIC WORKS**  
**SEWER DIVISION**

Sketch of Service Here

A large rectangular area filled with a grid of small squares, intended for a hand-drawn sketch of sewer service details.

Connection made in ..... Street.                      Work completed .....


Remarks: .....  
.....  
.....

DATE \_\_\_\_\_

TOWN OF LEXINGTON — BOARD OF PUBLIC WORKS  
SEWER DIVISION

Sketch of Service Here

25

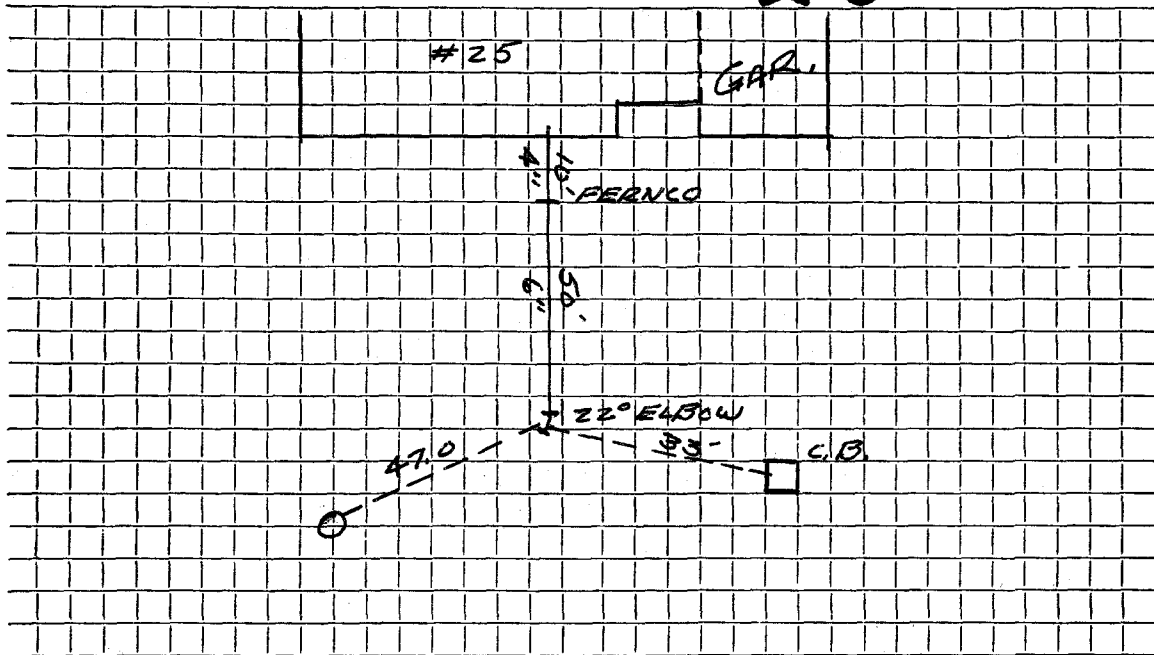

Connection made in SOLOMON PIERCE Street. Work completed .....

Remarks: Subdivision .....

.....  
.....