


DATE _____

TOWN OF LEXINGTON — BOARD OF PUBLIC WORKS
SEWER DIVISION

LOT # 43

Sketch of Service Here 29

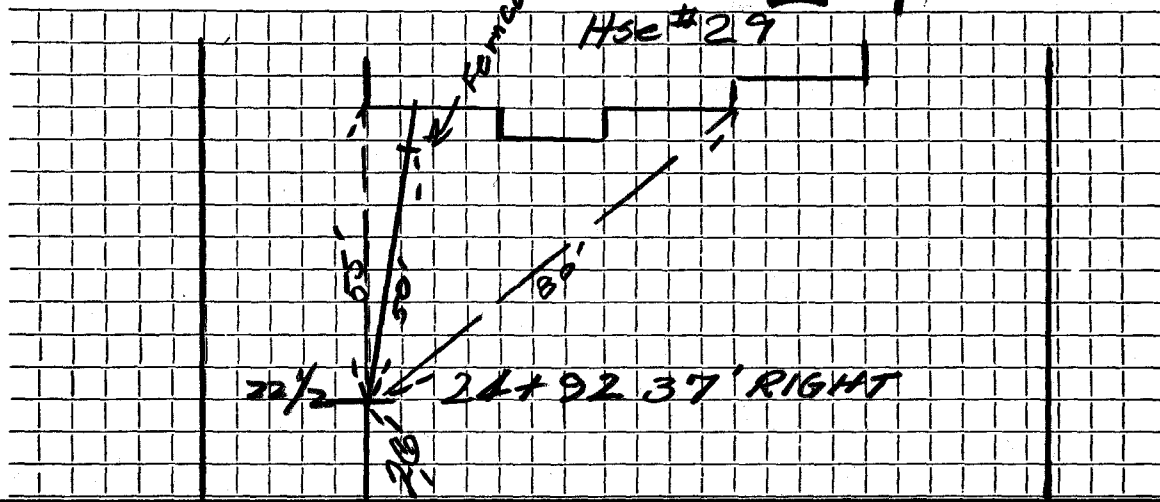

SMH 26+00¢

48'

SMH 24x50¢

SMH 21+50

Connection made in SOLOMON PIERCE Street.

Work completed 2' LEFT

Remarks: