


DATE _____

TOWN OF LEXINGTON — BOARD OF PUBLIC WORKS

SEWER DIVISION

Sketch of Service Here
#3 Solomon Pierce R.O.

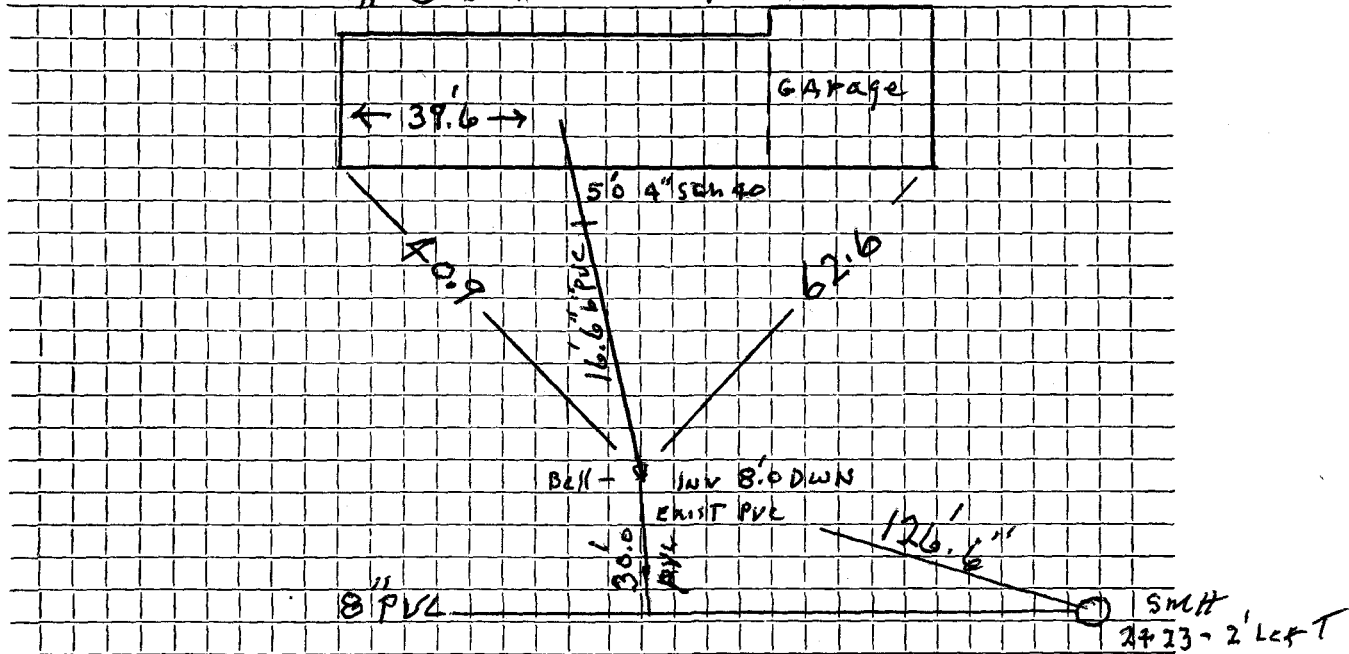

Connection made in Street. Work completed 2/1/06 J. McLaughlin

Remarks:

.....

.....