


DATE _____

TOWN OF LEXINGTON — BOARD OF PUBLIC WORKS

SEWER DIVISION

Sketch of Service Here

30

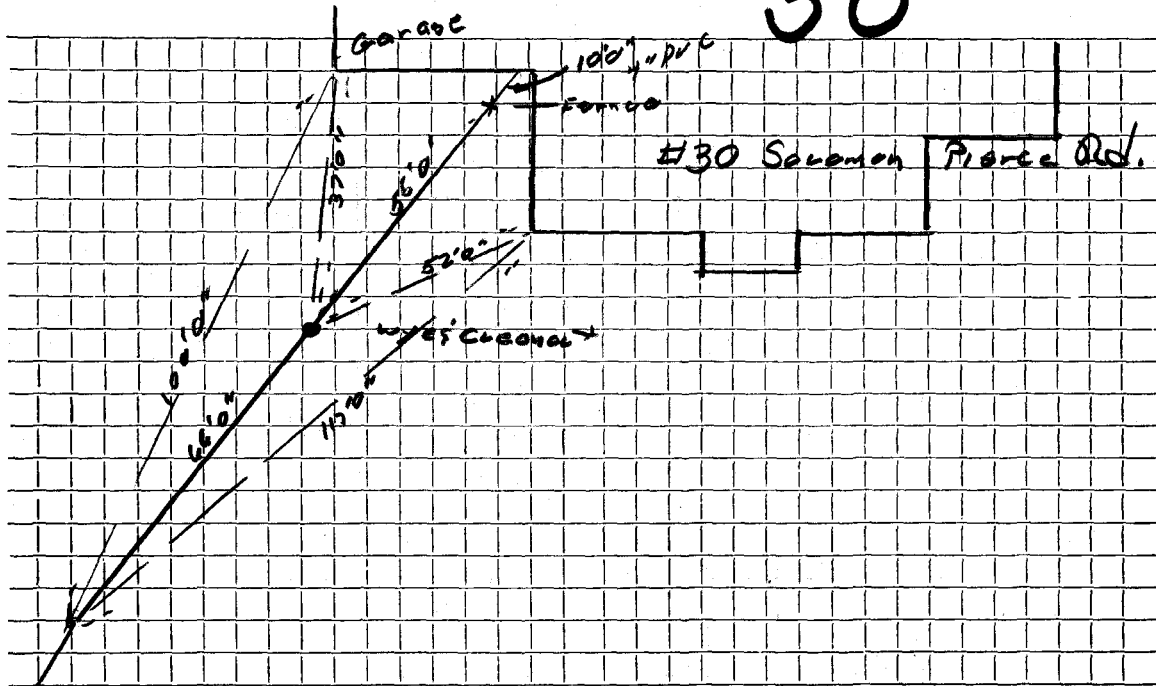

Connection made in Solomon Pierce Rd Street. Work completed 7/11/86

Remarks:

.....