

Name

Robert Cataldo

Service No.

Address **37 SOLOMON PIERCE ROAD. PHEASANT BROOK ESTATES**
LEXINGTON MASS

Location

Kind of Pipe

P.V.C.

Size 6"

Size of Main

8"

Repair—Renewal

New Service

McLaughlin

Location

Date	Material	Amount	Total	Date	Amount
	150' OF 8" P.V.C. SEWER MAIN	SMH 24+50¢	TO SMH 26+00¢		
	39' OF 6" P.V.C. SEWER SERVICE				
	101' OF 8" P.V.C. SEWER	SMH 26+00¢	TO SMH 27+03 2' LEFT		
	6" X 4" (FERRO) REDUCER				
	50' of 6" PVC				
	3' of 4" PVC				

DATE 6/26/90
G.T.S.


TOWN OF LEXINGTON — BOARD OF PUBLIC WORKS

SEWER DIVISION

LOT # 13

Sketch of Service Here

32

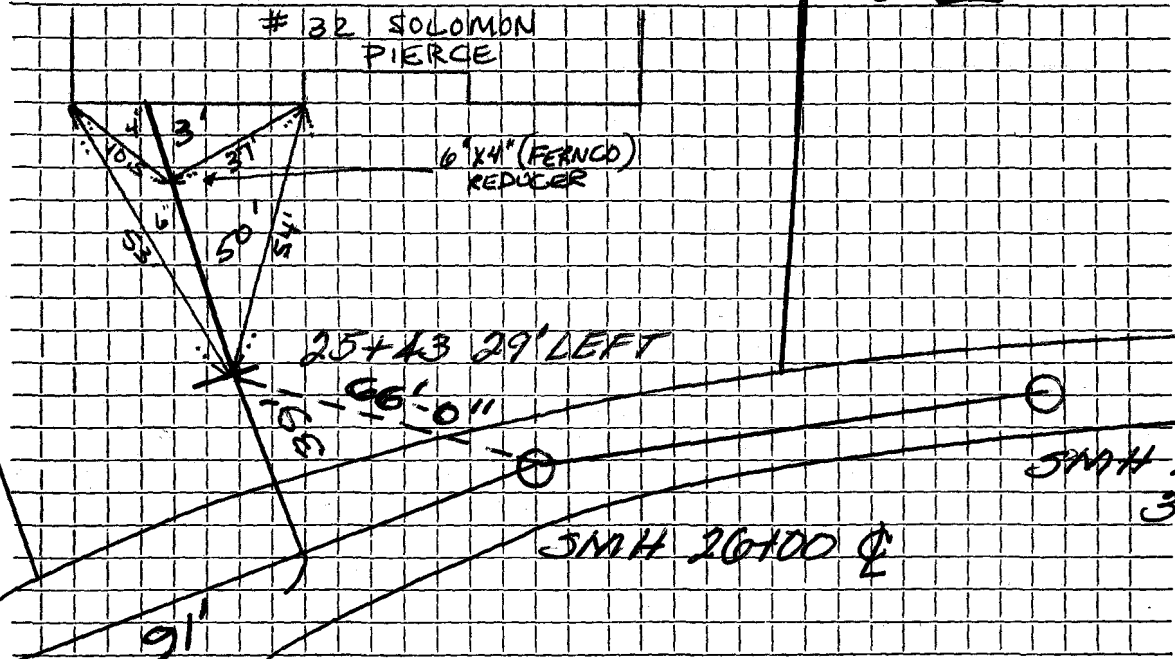

3MH 24+50

Connection made in SOLOMON PIERCE Rd. Street.

Work completed

Remarks: .. INSPECTED: G.T. SAMAKA

..... CONTRACTOR: J. MCLAUGHLIN