


DATE 7/ / 90

TOWN OF LEXINGTON — BOARD OF PUBLIC WORKS

PAB

SEWER DIVISION

Sketch of Service Here 34

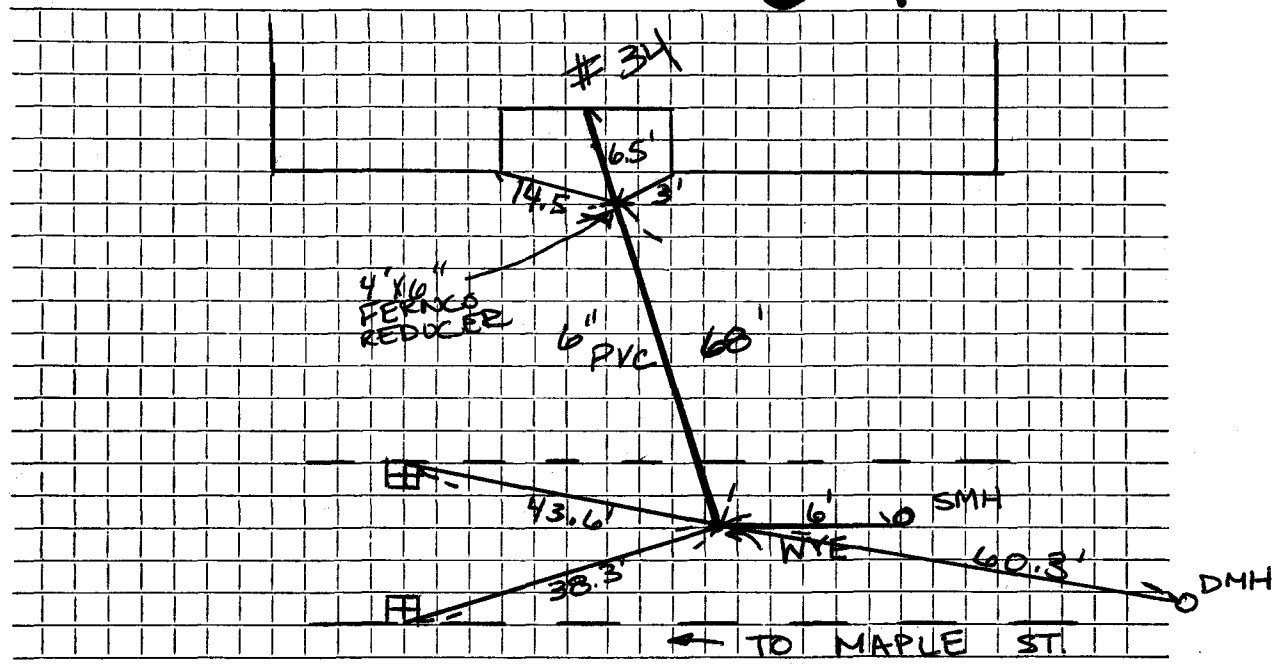

Connection made in ... SOLOMON PIERCE Street. Work completed

Remarks: INSPECTED: P. BARRONS
CONTRACTOR: J. McLAUGHLIN