


DATE _____

TOWN OF LEXINGTON — BOARD OF PUBLIC WORKS
SEWER DIVISION

Sketch of Service Here

35

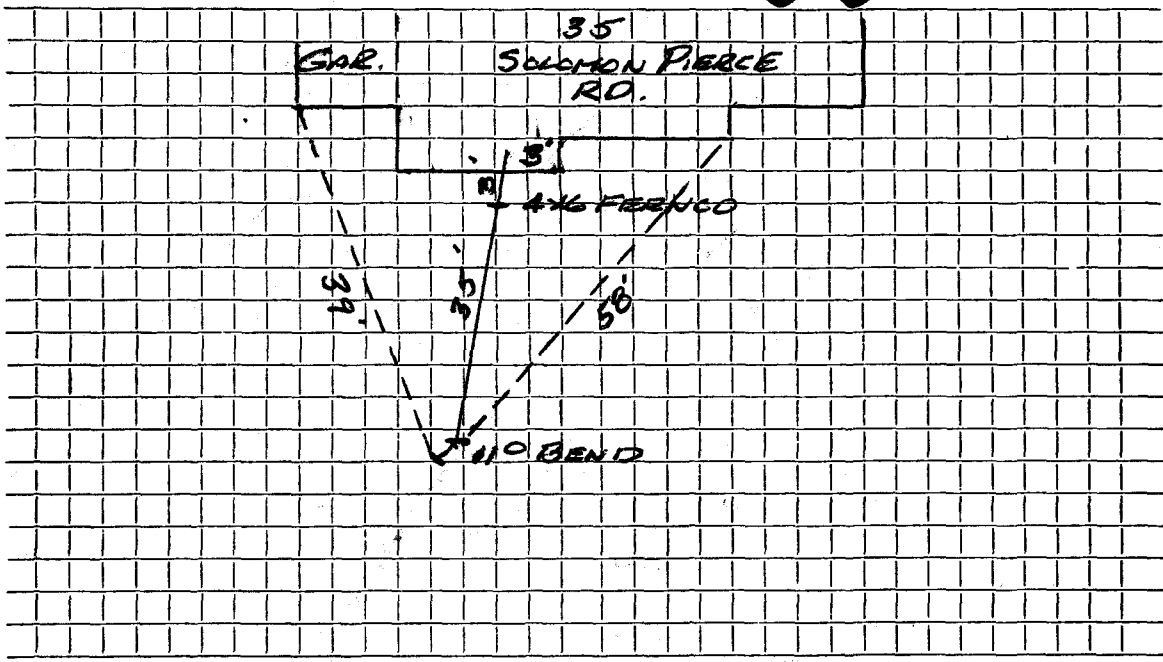

Connection made in SOLOMON PIERCE RD. Street.

Work completed

Remarks:

.....