


DATE _____

TOWN OF LEXINGTON — BOARD OF PUBLIC WORKS

SEWER DIVISION

LOT # 11

Sketch of Service Here
36 Solomon Pierce Rd 36

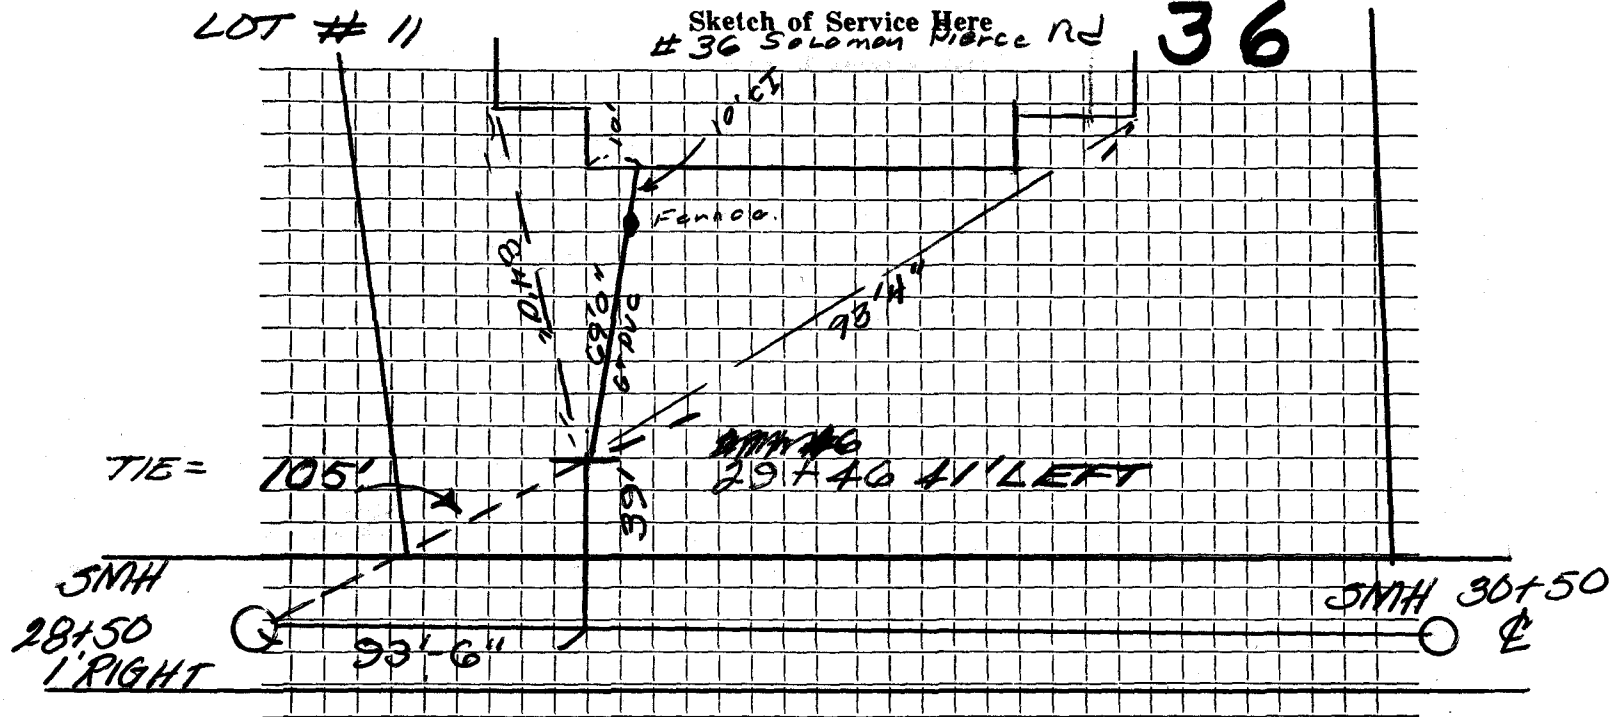

Connection made in SOLOMON PIERCE Street. Work completed PRG

Remarks: