

DATE _____


TOWN OF LEXINGTON — BOARD OF PUBLIC WORKS

SEWER DIVISION

LOT # 10

Sketch of Service Here

38

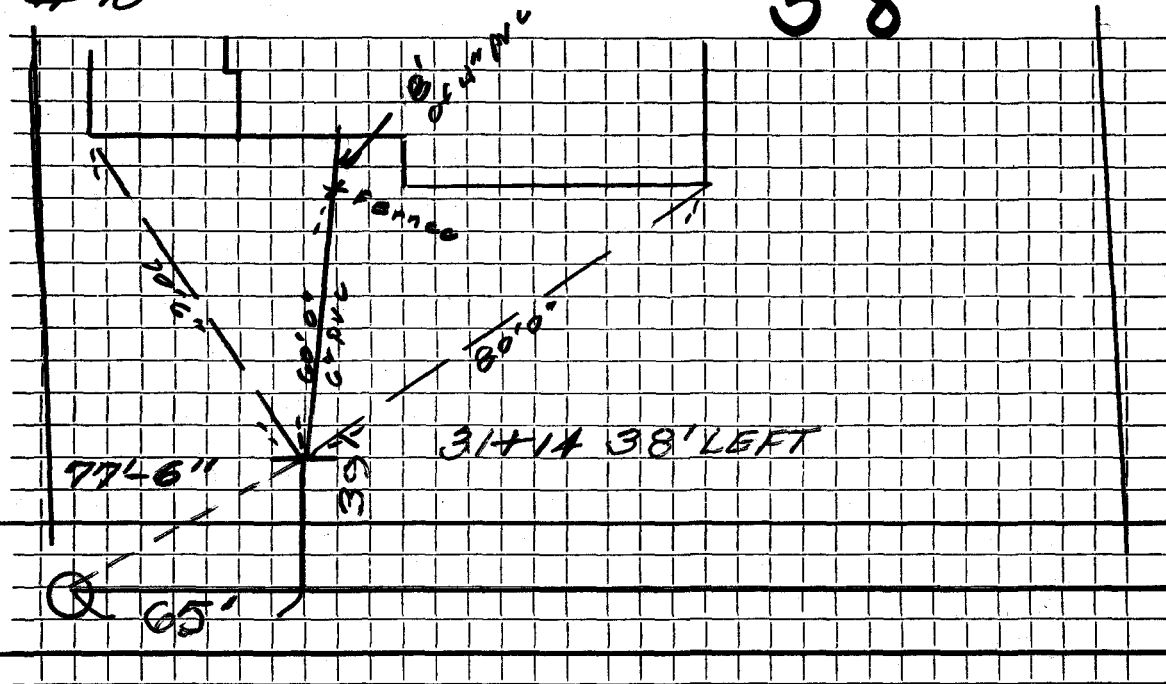

SMH
~~28+50~~ 2
30+50

SMH
33+52 2

Connection made in SOLDMAN PIERCE Street. Work completed 4/15/86

Remarks: