




DATE \_\_\_\_\_

TOWN OF LEXINGTON — BOARD OF PUBLIC WORKS

SEWER DIVISION

Sketch of Service Here **39**

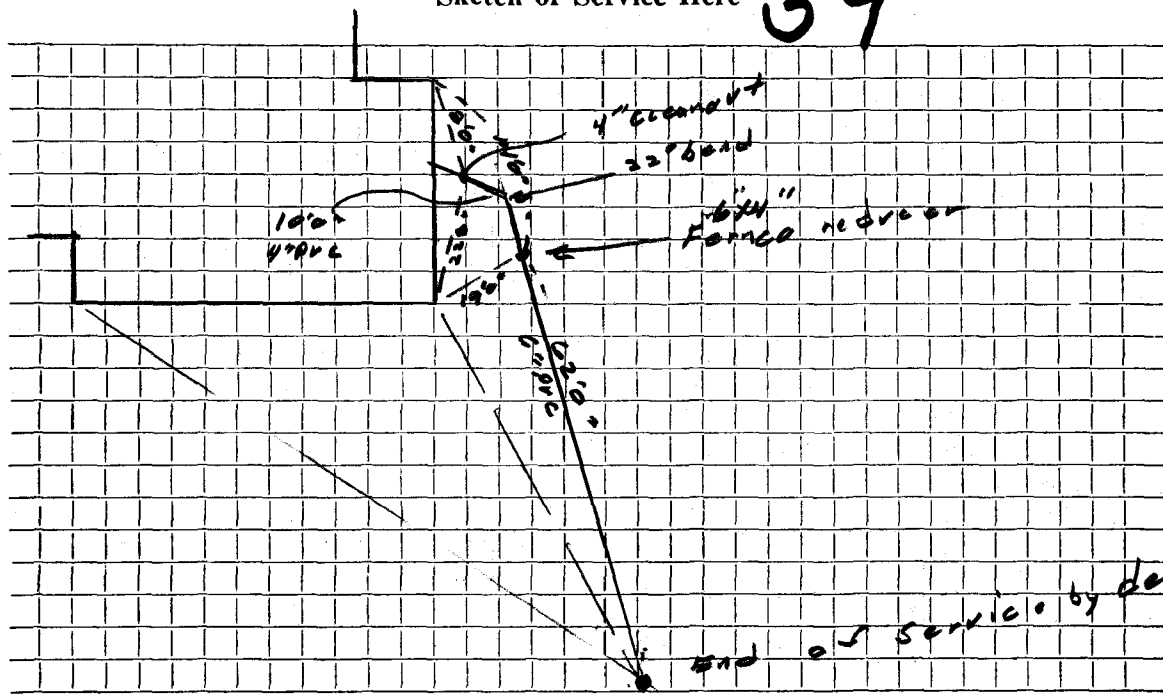

Connection made in Satanan Pierce R.d. Street.

Work completed ..... 1986 .....

Remarks: .....