

Name

Service No.

Address

4 Solomon Pierce Road

4 Solomon Pierce Rd.

Location

Kind of Pipe

PVC

Size

6"

Size of Main

8" PVC

Repair—Renewal

(New Service)

Location

Date

Material

Amount

Total

Date

Amount

1986

① Fernco 6"X6"

① Fernco reducer 6"X4"

37'6" of 6" PVC.

8'0" of 4" PVC

19' 6" P.V.C.


1 6"X8" Wye

DATE \_\_\_\_\_

TOWN OF LEXINGTON — BOARD OF PUBLIC WORKS  
SEWER DIVISION

Sketch of Service Here

4

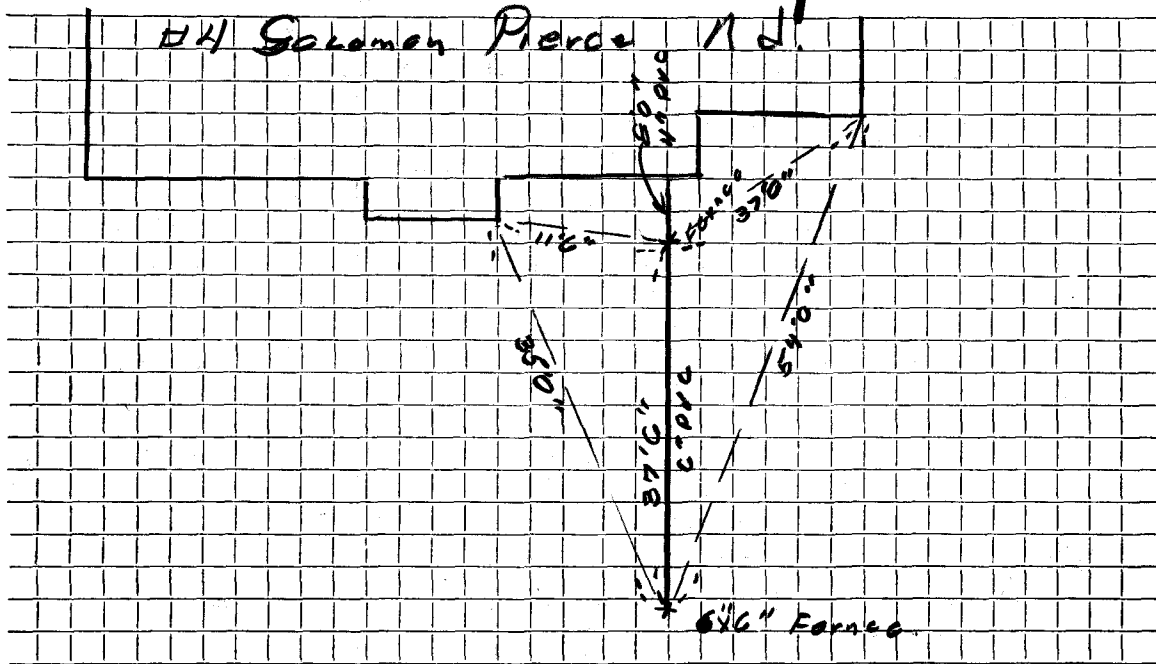

Connection made in Solomon Pierce Rd Street

Work completed ..... 1966 .....

Remarks: .....