

Name LOT # 9

Service No.

Address SOLOMON PIERCE ROAD PHEASANT BROOK ESTATES
LEXINGTON MASS Location

Kind of Pipe P.V.C.

Size 6"

Size of Main 8"

Repair—Renewal New Service


Location

Date	Material	Amount	Total	Date		Amount
	302' OF 8" P.V.C. SEWER MAIN	SMH 30+50	☒	TO SMH 33+52	☒	
	26' OF 6" P.V.C. SEWER SERVICE					
4/14/86	① 22° 4" bend					
	① 6"x4" Fernco reducer					
	① 4" wye & clean out					
	46' of 6" PVC					
	7'10" " 4" "					

DATE _____

TOWN OF LEXINGTON — BOARD OF PUBLIC WORKS

SEWER DIVISION

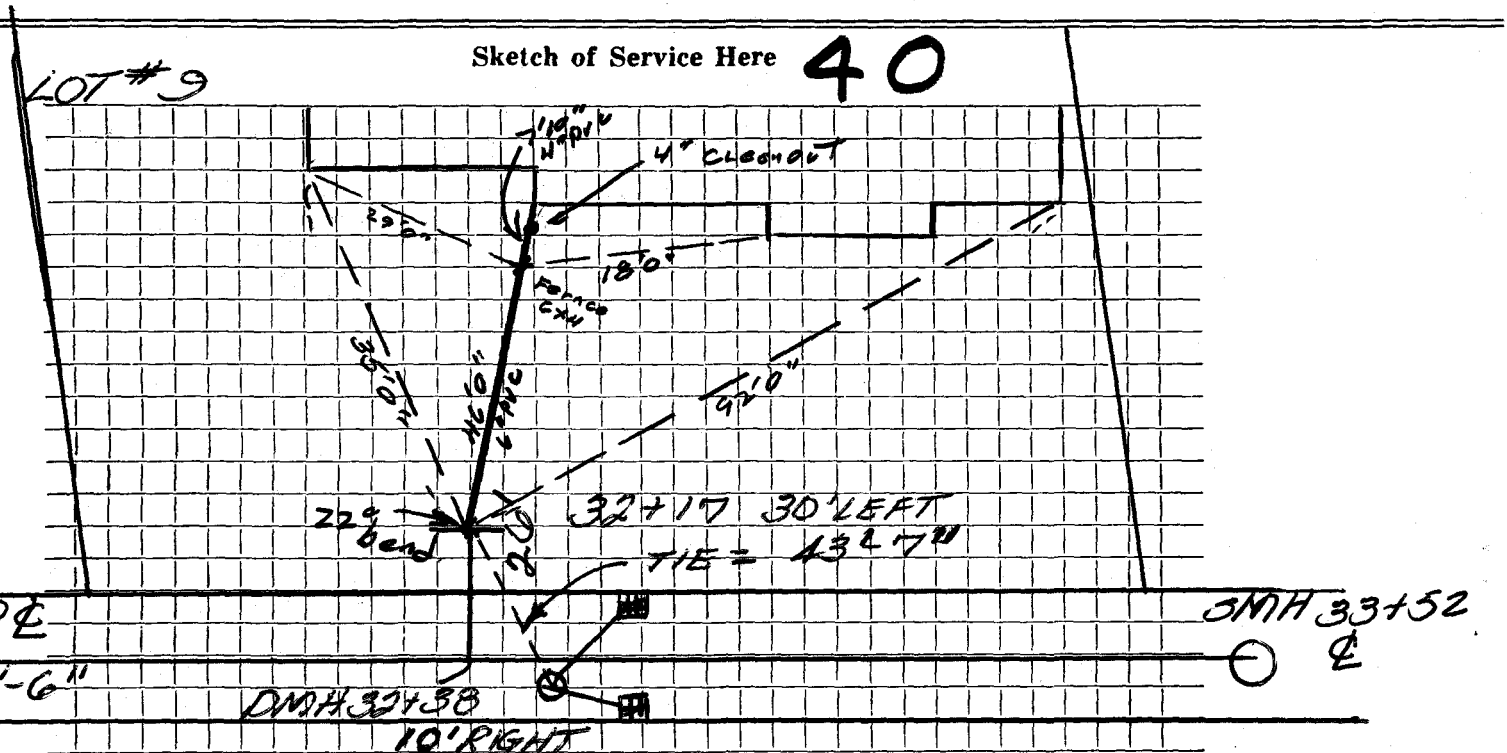

Connection made in SOLOMON PIERCE Street. Work completed

Remarks:

.....

.....