

DATE _____


TOWN OF LEXINGTON — BOARD OF PUBLIC WORKS

SEWER DIVISION

Sketch of Service Here

#43 Solomon Pierce Rd.

43

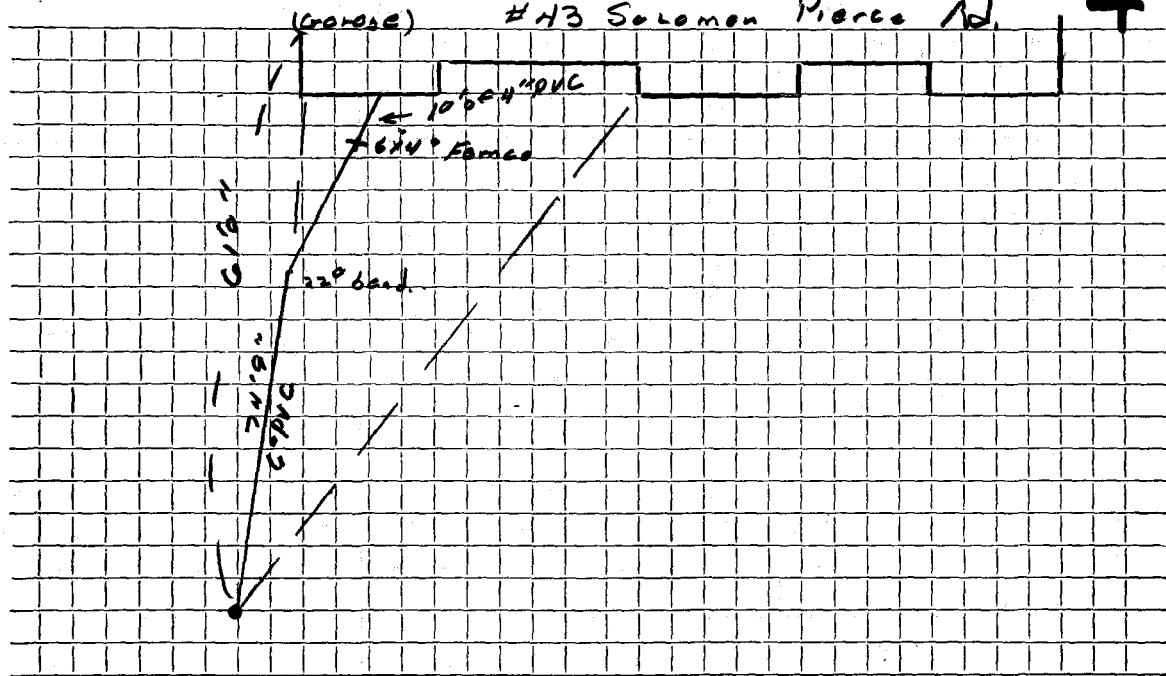

Connection made in Street. Work completed

Remarks:

.....