


DATE _____

TOWN OF LEXINGTON — BOARD OF PUBLIC WORKS

SEWER DIVISION

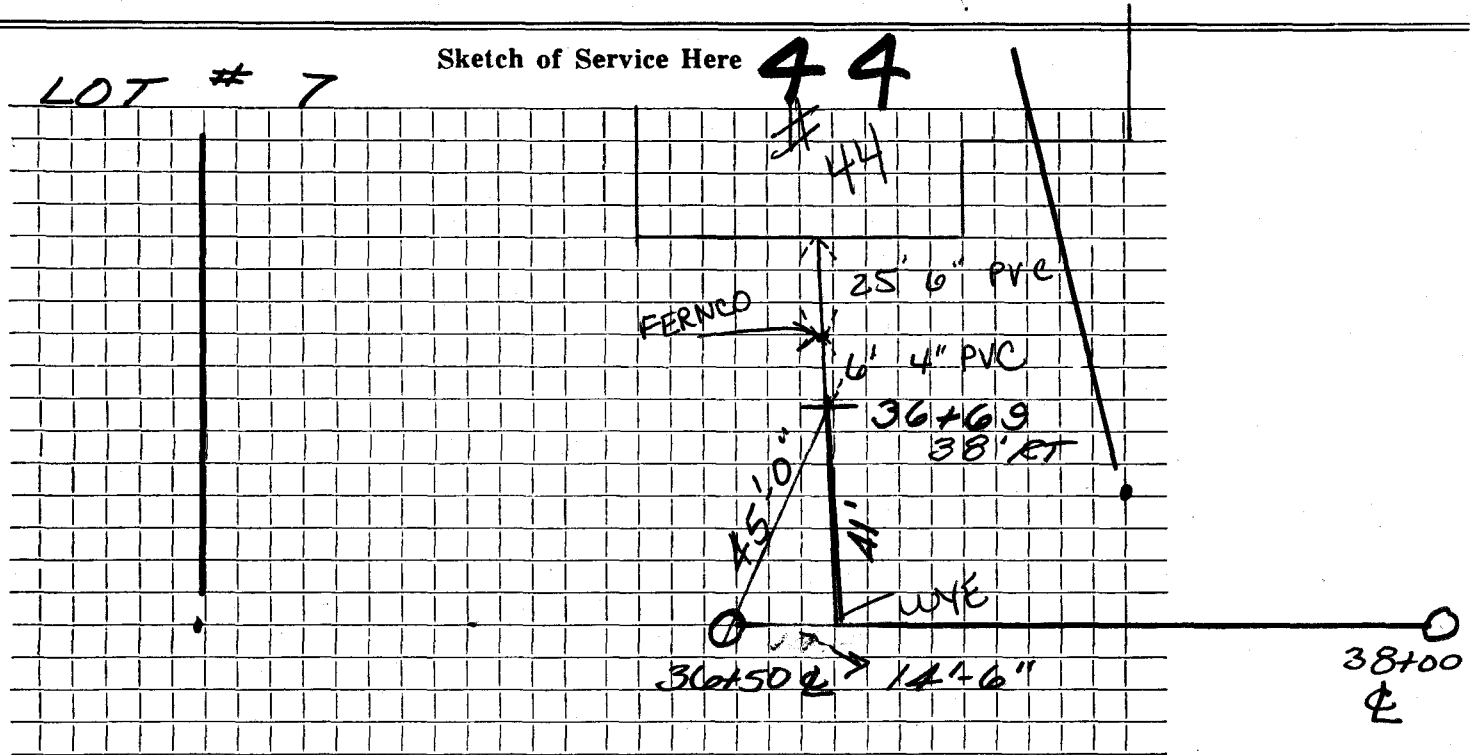

Connection made in ... SOLOMON PIERCE Street. Work completed

Remarks: ... 8" X 8" X 6" T

... DEPTH = 10'

.....