

Name

Service No.

Address

45 Solomon Pierce Road

LOT 59

45 Solomon Pierce Road

Location Pleasant Brook Estates

Kind of Pipe

P.V.C.

Size

6"

Size of Main

8"

Repair—Renewal—

New Service

Location

Date

Material

Amount

Total

Date

Amount


35' (6" P.V.C. SEWER SERVICE N.C.)

300' 3" MH 38" Ø TO 4" Ø 8" SEWER MAIN (P.V.C.)
2' LT

DATE _____

TOWN OF LEXINGTON — BOARD OF PUBLIC WORKS

SEWER DIVISION

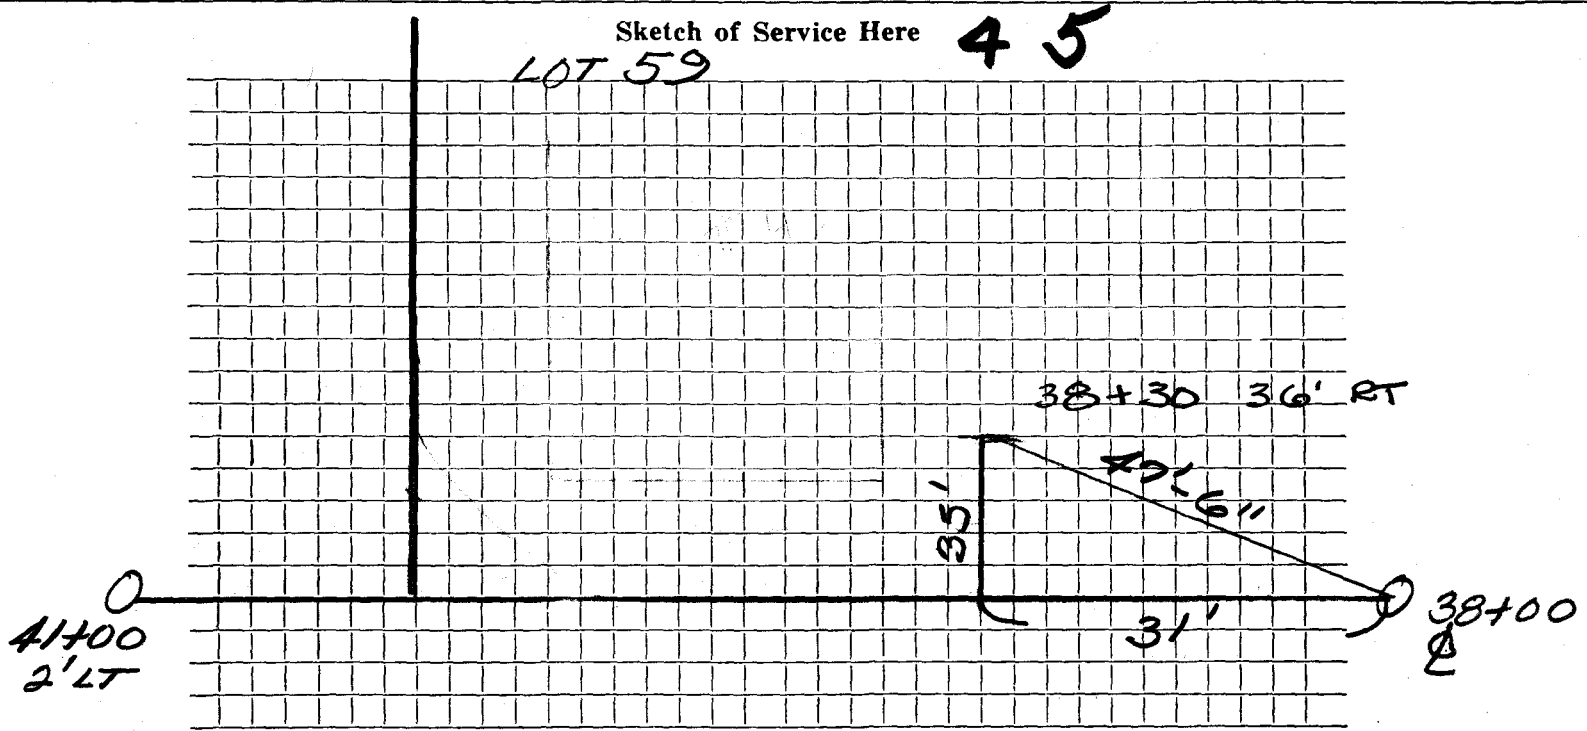

Connection made in SOLOMON PIERCE Street. Work completed

Remarks: 8" X 8" X 6" T
DEPTH = 11"