

Name

Service No.

Address 48 Saloman Pierce Road

Lot 6

48 Saloman Pierce Road

Location Pheasant Brook Estates

Kind of Pipe P.V.C.

Size 6"

Size of Main 8"

Repair—Renewal New Service

Location

Date	Material	Amount	Total	Date	Amount
	31' (6" P.V.C. & SEWER SERVICE N.C.)				
	300' 8" P.V.C. MAIN		38+00 TO 41+00	2' LT	
			Ⓢ		
5/6/86	① 6" X 4" Fernco reducer				
	74' 6" of 6" PVC				
	9' 0" " 4" "				

DATE _____


TOWN OF LEXINGTON — BOARD OF PUBLIC WORKS

SEWER DIVISION

Sketch of Service Here

LOT # 6

48

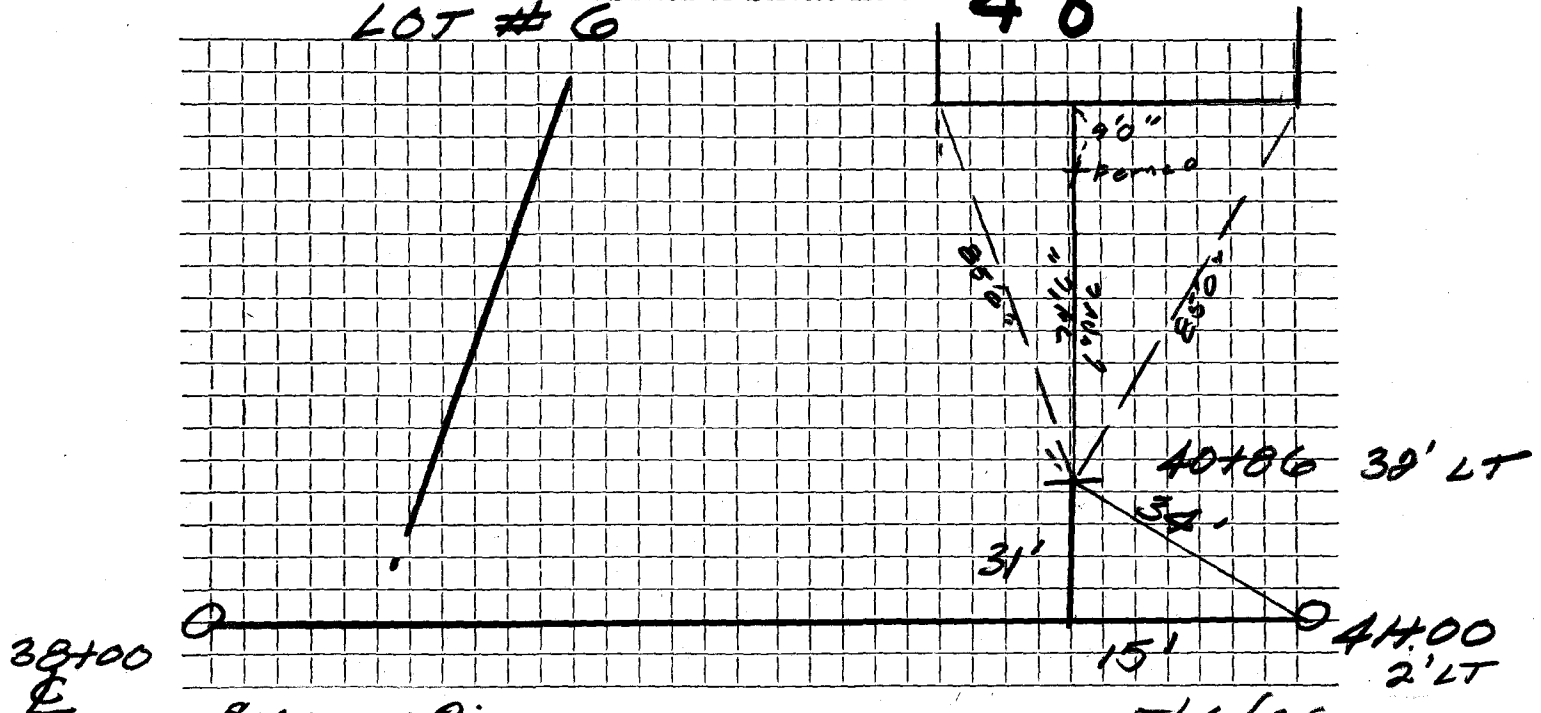

Connection made in SOLAMON PIERCE Street.

Work completed 5/6/80

Remarks: 8" x 8" x 6" T
DEPTH = 5'