

Name

Service No.

Address

49 Solomon Pierce Rd.

(LOT 61)

49 Solomon Pierce Road

Location

Pleasant Brook Estates

Kind of Pipe

P.V.C.

Size

6"

Size of Main

8"

Repair—Renewal—

New Service

Location

Date	Material	Amount	Total	Date	Amount
	300' S.W.I.T.H. 4" HO 2' LT TO S.W.I.T.H. 4" HO 8" P.V.C. MAIN				
	1' P.V.C.				
	3' PRESSURE PIPE			CL. 80	
	(1) 22° MECHANICAL BEND				
	* 26' P.V.C. SEWER SERVICE			6" N.C.	
				(Service over water main)	
12/20 88	23' PVC				




DATE \_\_\_\_\_

# TOWN OF LEXINGTON — BOARD OF PUBLIC WORKS

## SEWER DIVISION

Sketch of Service Here **49**

LOT 61

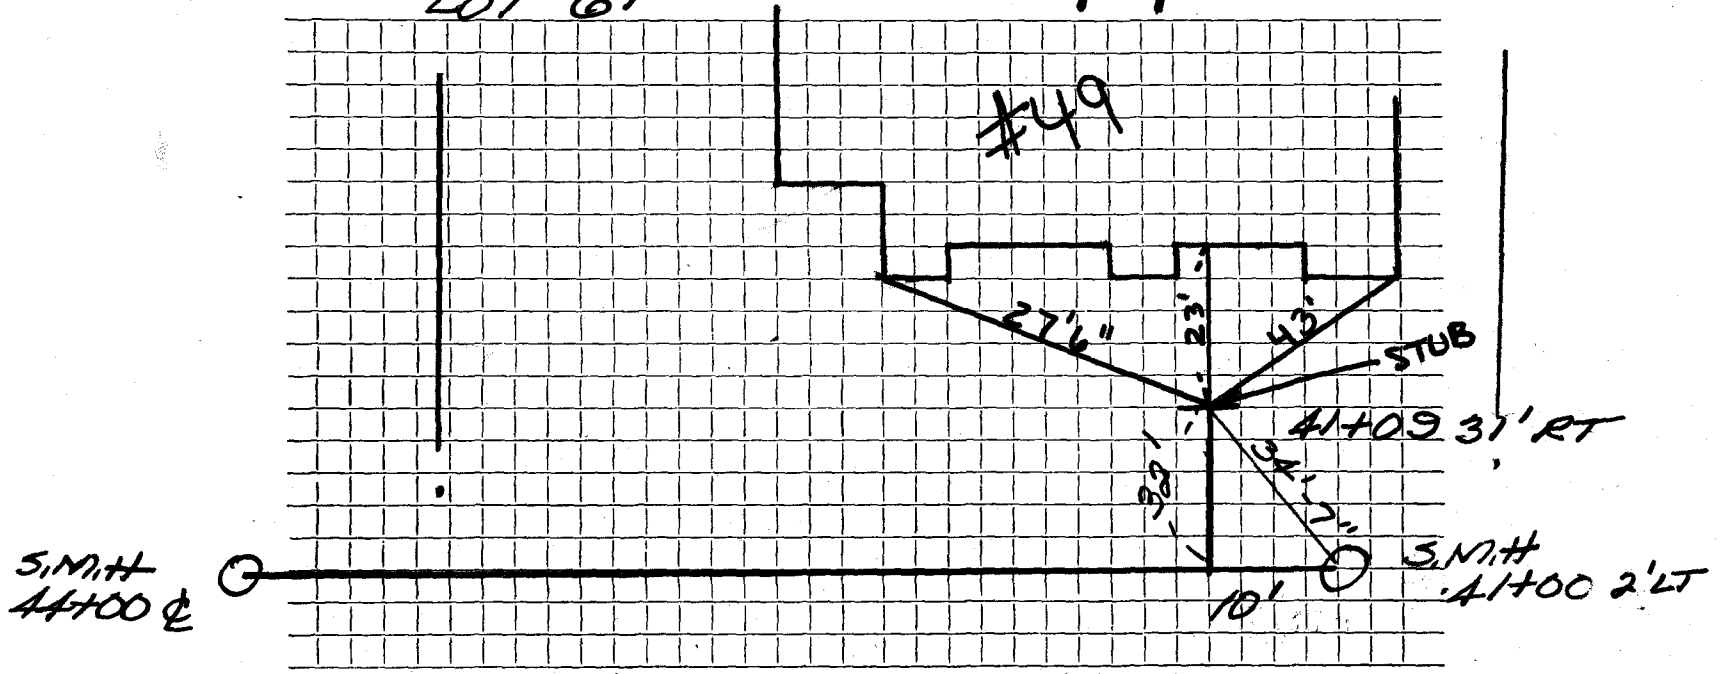

Connection made in SOLOMON PIERIE Street.

Work completed .....

Remarks: 8X8X6" T

DEPTH = 1 (OVER DRAIN PIPE)

e TIME OF CONSTRUCTION will be back filled.