


DATE _____

TOWN OF LEXINGTON — BOARD OF PUBLIC WORKS
SEWER DIVISION

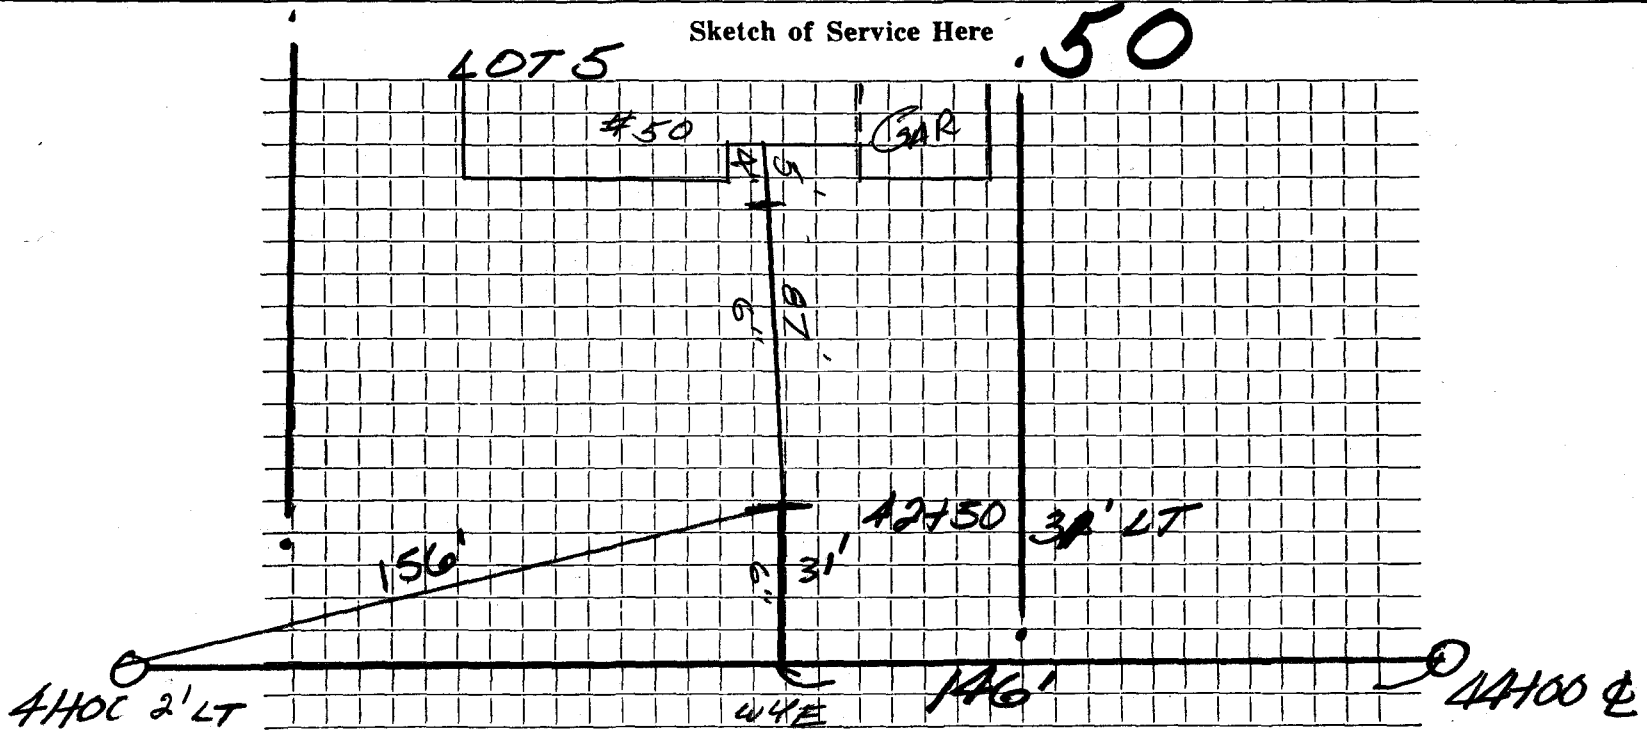

Connection made in ... SOLOMON PIQUET Street. Work completed

Remarks: 8x8x6' T
DEPTH = 5'