

Name

Service No.

Address 52 Solomon Pierce Road

Lot 4

52 Solomon Pierce Road

Location Pheasant Brook Estates

Kind of Pipe P.V.C.

Size 6"

Size of Main 8"

Repair—Renewal New Service

Location

Date

Material

Amount

Total

Date

Amount

39' SEWER SERVICE 6" P.V.C. N.C.

150' S.M.H 4400 \$ TO 45750 \$ 8" P.V.C SEWER MAIN

1986 ① 22 1/2 Bond.

60' of 6" P.V.C.

✓

DATE \_\_\_\_\_

TOWN OF LEXINGTON — BOARD OF PUBLIC WORKS


SEWER DIVISION

±

Sketch of Service Here

52

LOT # 4

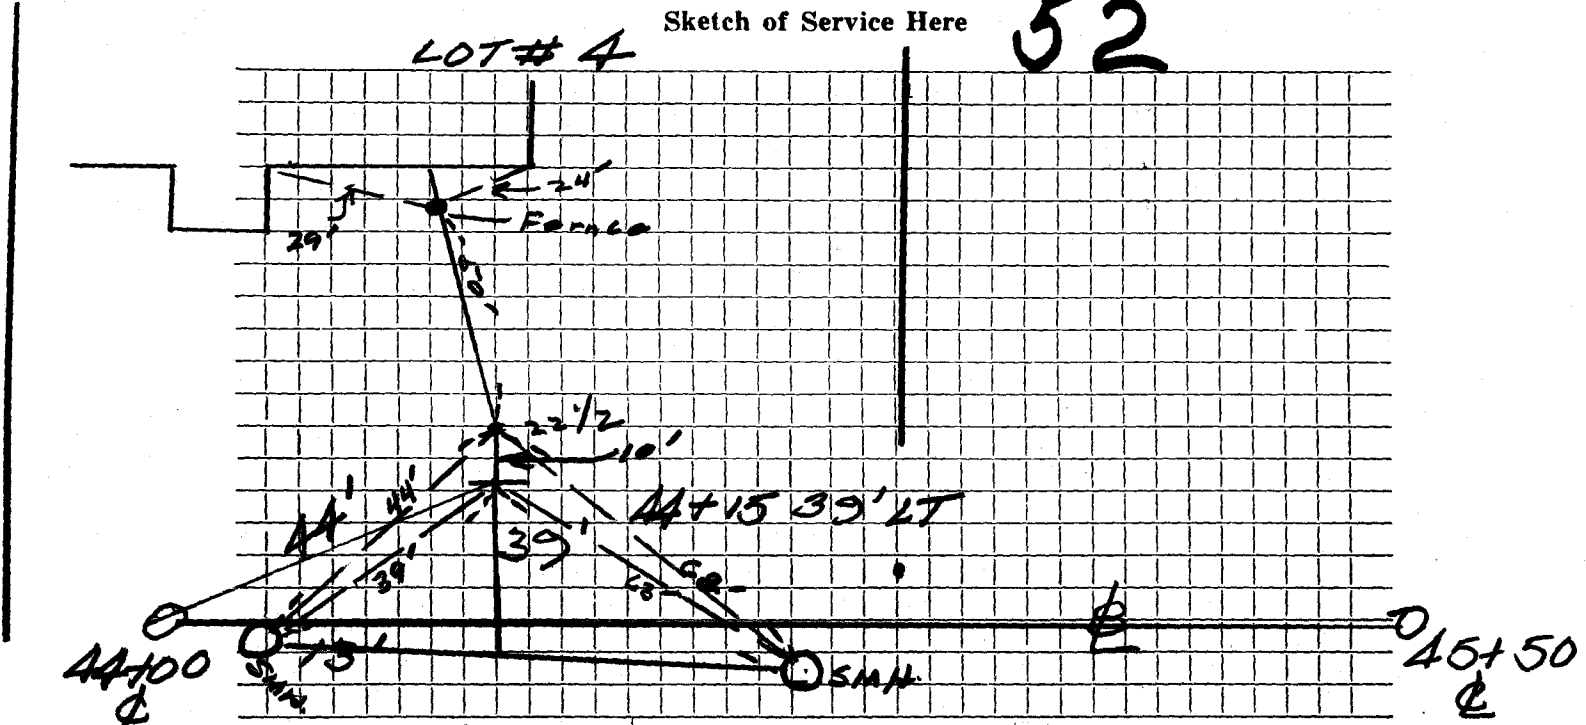

Connection made in SOLDAN PIERCE Street. Work completed .....

Remarks: 8" x 6" T  
DEPTH = 1' @ TIME OF CONSTRUCTION  
WILL BE BACK FILLED.