

Name Dec Builders

Service No.

Address 53 Solomon Pierce Road

Lot 63

53 Solomon Pierce Road

Location Pheasant Brook Estates

Kind of Pipe P.V.C.

Size 6"

Size of Main 8"

Repair—Renewal New Service Valeri #4282

Location


Date	Material	Amount	Total	Date	Amount
	150' S.I.N.H	44+00 @	TO S.M.H	50	43+50 @ 8" P.V.C. MAIN
	2' 6" P.V.C.	@	SEWER SERVICE		
	COUPLING	1'			
	37' PRESSURE PIPE		N.C.		
	32 LF 6" PVC				
	5 LF 4" PVC				
	4 LF 6" FERRO				



DATE _____

TOWN OF LEXINGTON — BOARD OF PUBLIC WORKS SEWER DIVISION

Sketch of Service Here
LOT 63 53

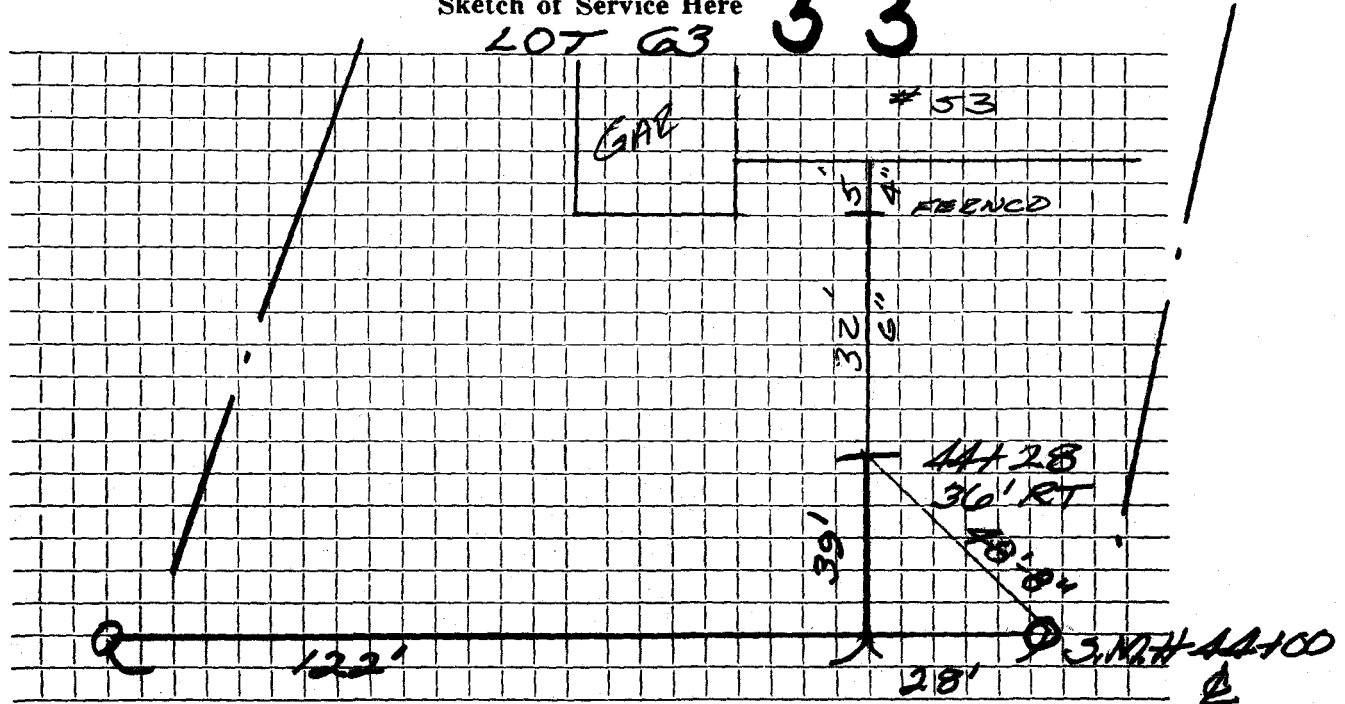

S.M.H.
15+50

S.M.H. 15+100

Connection made in SOLOMON PIERCE Street. Work completed

Remarks: 8" X 8" X 6" T
DEPTH = 1'-6" TIME OF CONSTRUCTION WILL BE BACK FILLED