

Name

Service No.

Address 54 Solomon Pierce Road.

Lot 3

54 Solomon Pierce Road

Location Pheasant Brook Estates

Kind of Pipe P.V.C.

Size 6"

Size of Main 8"

Repair—Renewal New Service

Location

Date	Material	Amount	Total	Date	Amount
------	----------	--------	-------	------	--------

	26' (6" P.V.C. SERVICE NC)				
	150' 3/4" 44100 &				8" P.V.C. MAIN


6/21/86

① 6" x 4" Fernco reducer
 44' 0" of 6" PVC
 10' 0" " 4" "

DATE _____

TOWN OF LEXINGTON — BOARD OF PUBLIC WORKS

SEWER DIVISION

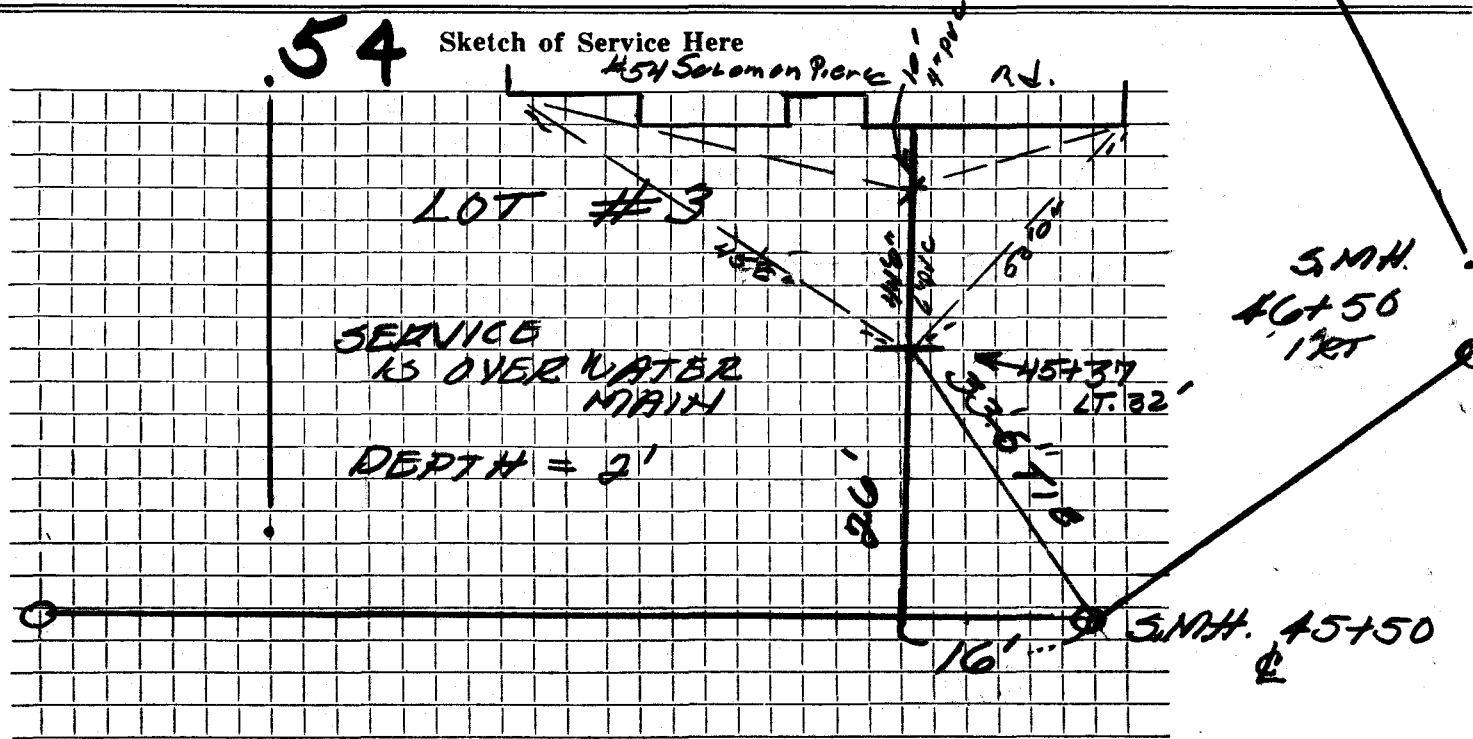

Connection made in SOLOMON PIERCE Street. Work completed

Remarks: 8" x 8" x 6" T. Y.

DEPTH = 2' @ TIME OF CONSTRUCTION

WILL BE BACK FILLED