

Name

Service No.

Address # 55 Solomon Pierce Rd.

55 Solomon Pierce Road

Location

Kind of Pipe PVC

Size 6"

Size of Main 8" PVC.

Repair—Renewal (New Service)

Location

Date	Material	Amount	Total	Date		Amount
------	----------	--------	-------	------	--	--------

1986

48'0" of 6" PVC

8'0" " 4" CI

① 6"x4" Fernco reducer

① 6" 22° band


① C.I. saddle

DATE \_\_\_\_\_

TOWN OF LEXINGTON — BOARD OF PUBLIC WORKS

SEWER DIVISION

Sketch of Service Here **55**

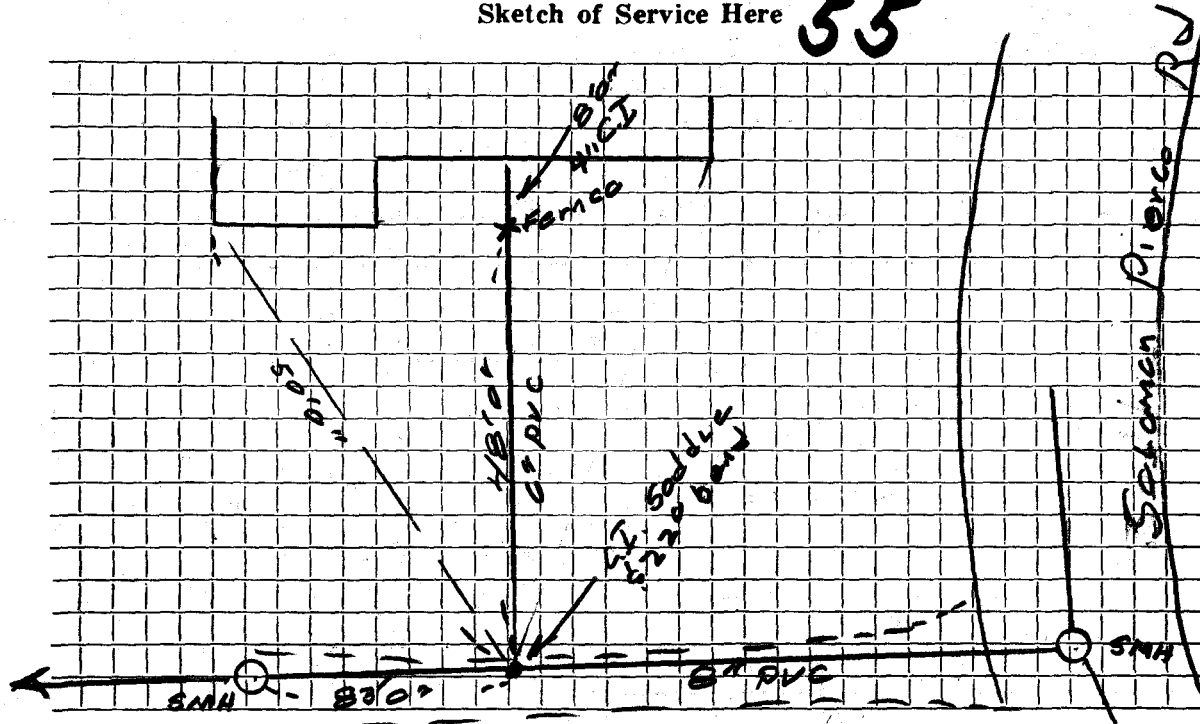

Connection made in ..... Street. Work completed .....

Remarks: .....  
.....  
.....