

Name

Service No.

Address 58 Solomon Pierce Road

Lot # 2

58 Solomon Pierce Road

Location Pheasant Brook Estates

Kind of Pipe P.V.C.

Size 6" SERVICE

Size of Main 8" MAIN

Repair—Renewal—New Service


Location

Date	Material	Amount	Total	Date	Amount
	26'	6" P.V.C. SERVICE			
	277' S.M.H.	47.50	TO 50+25	8' RIGHT	8" P.V.C. MAIN
3/17/86	(2) 22 1/2 Bands				
	54.5' of 6" P.V.C.				

DATE _____

TOWN OF LEXINGTON — BOARD OF PUBLIC WORKS

SEWER DIVISION

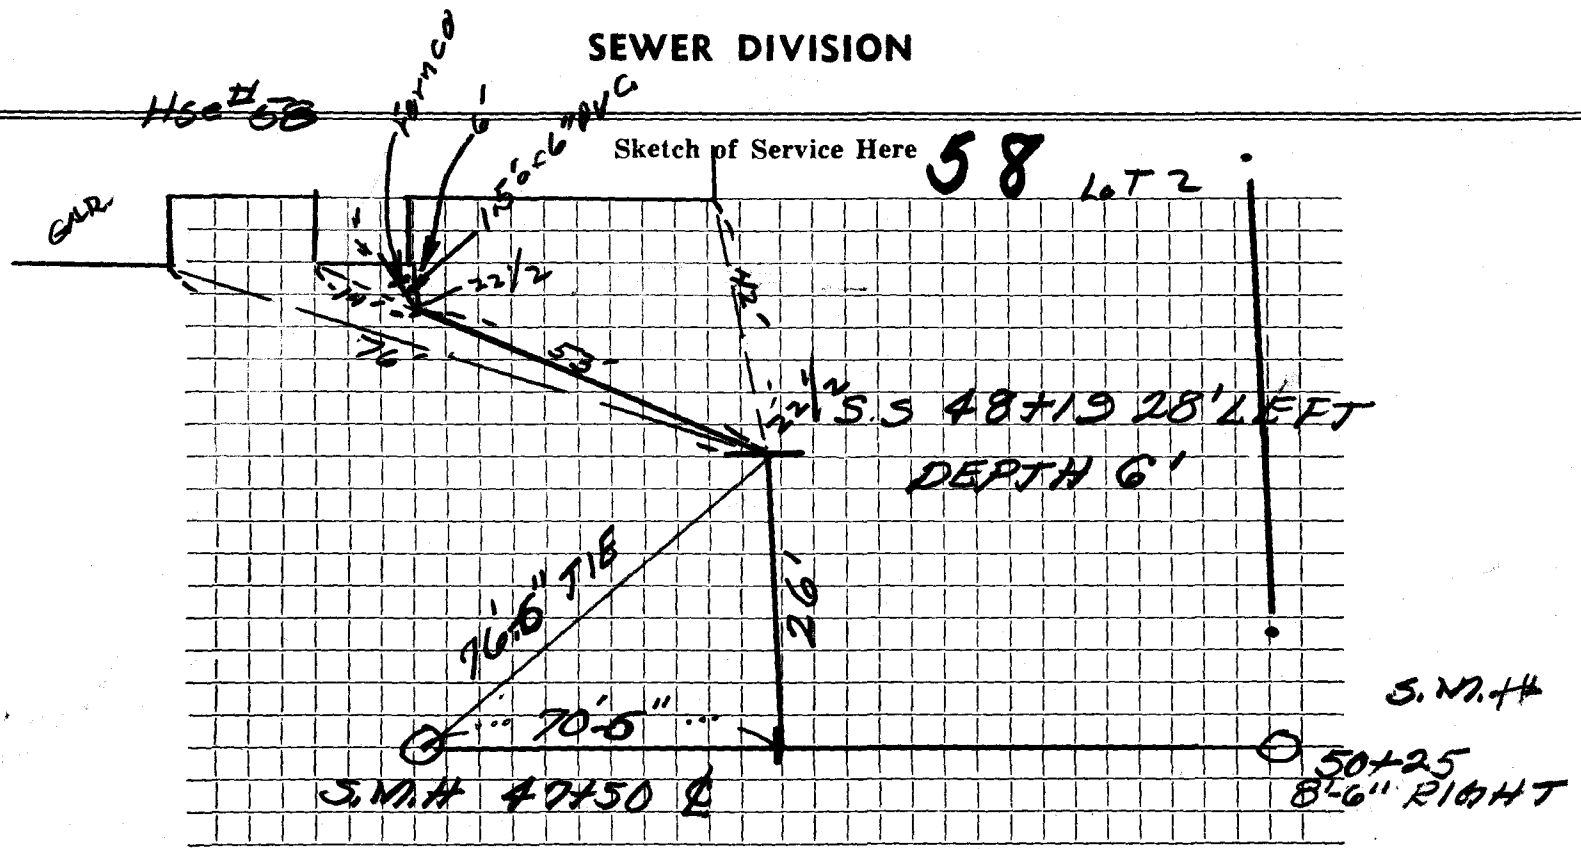

Connection made in SOLOMON PIERCE street. Work completed

Remarks: 8" X 8" X 6" T.Y.

DEPTH = 6'