


DATE _____

TOWN OF LEXINGTON — BOARD OF PUBLIC WORKS

SEWER DIVISION

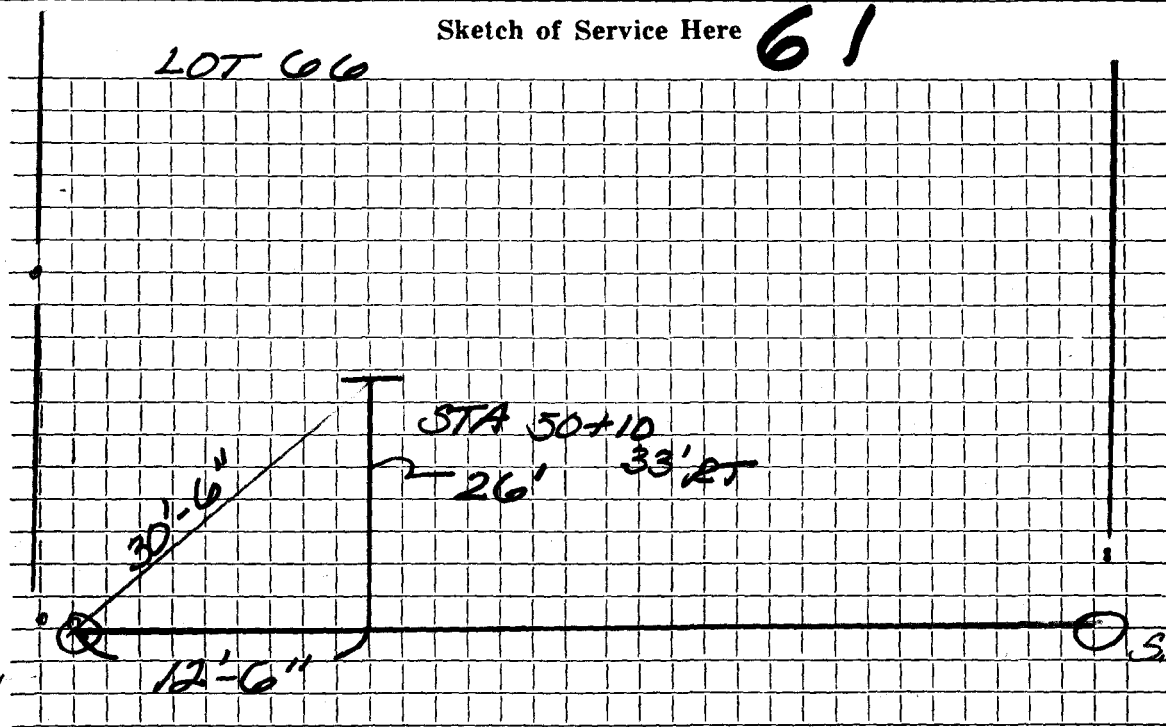

S.M.H.
50+25 8'-6"

Connection made in SOLONMAN PIERUS Street. Work completed

Remarks: 8" X 8" X 6" T

DEPTH = 9'