

Name

Service No.

Address 63 Solomon Pierce Road

LOT 67

63 Solomon Pierce

Location Pheasant Brook Estates

Kind of Pipe

P.V.C.

Size 6"

Size of Main

8"

Repair—Renewal

New Service

Location

Date	Material	Amount	Total	Date	Amount
	26' (6" P.V.C. SEWER SERVICE NC)				
	152' SAND # 50 + 25 TO 51 + 25 @ 8" P.V.C. MAIN				
			8' 6" RT		
3/14/86	(2) 22 1/2 Bends				
	(1) Fernco				
	65' of 6" P.V.C.				
	10" " " "				


DATE _____

TOWN OF LEXINGTON — BOARD OF PUBLIC WORKS

SEWER DIVISION

Sketch of Service Here

63

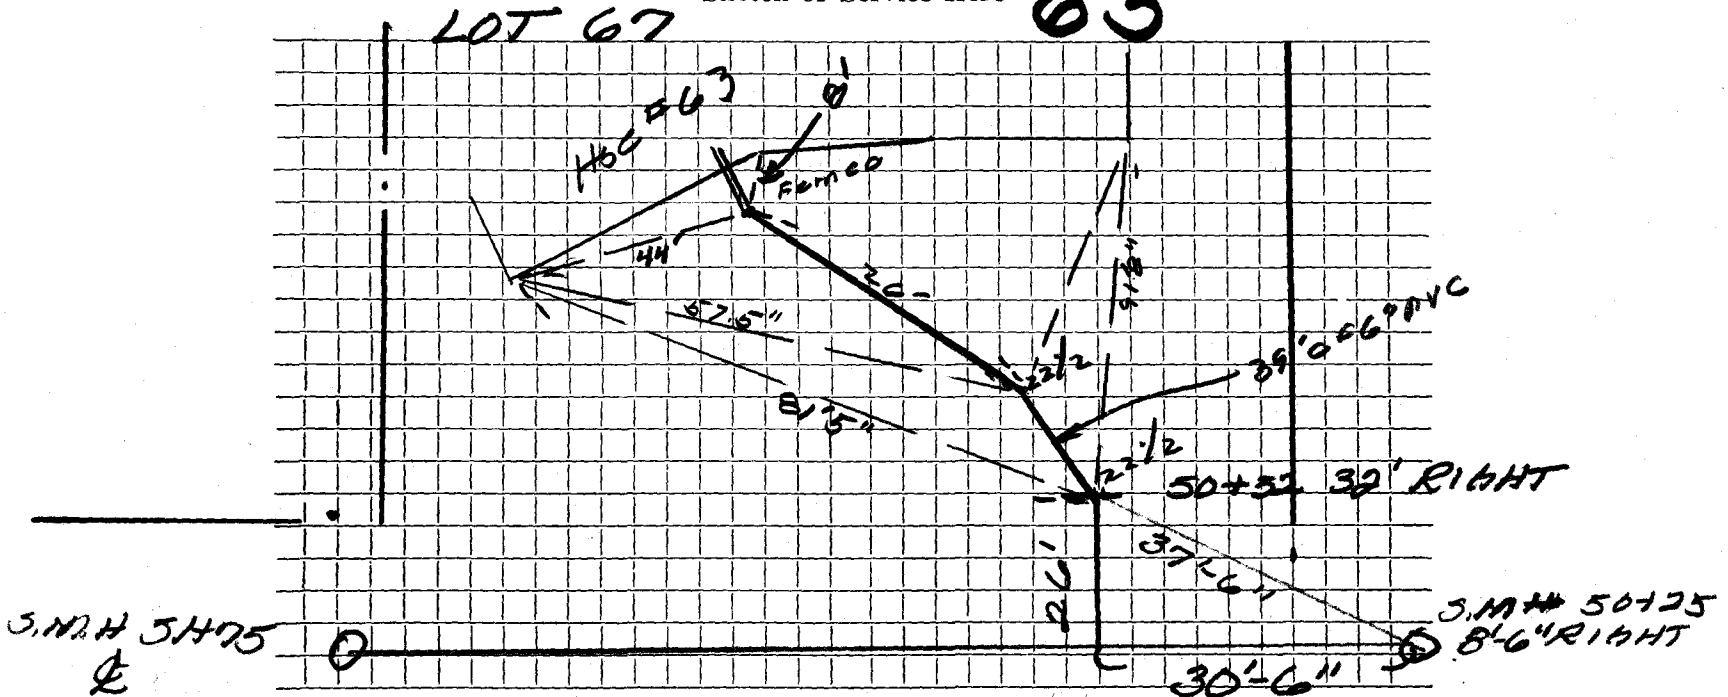

Connection made in SOLOMON PIERRE Street. Work completed

Remarks: 8" X 6" T DEPTH = 9'