




DATE \_\_\_\_\_

TOWN OF LEXINGTON — BOARD OF PUBLIC WORKS

SEWER DIVISION

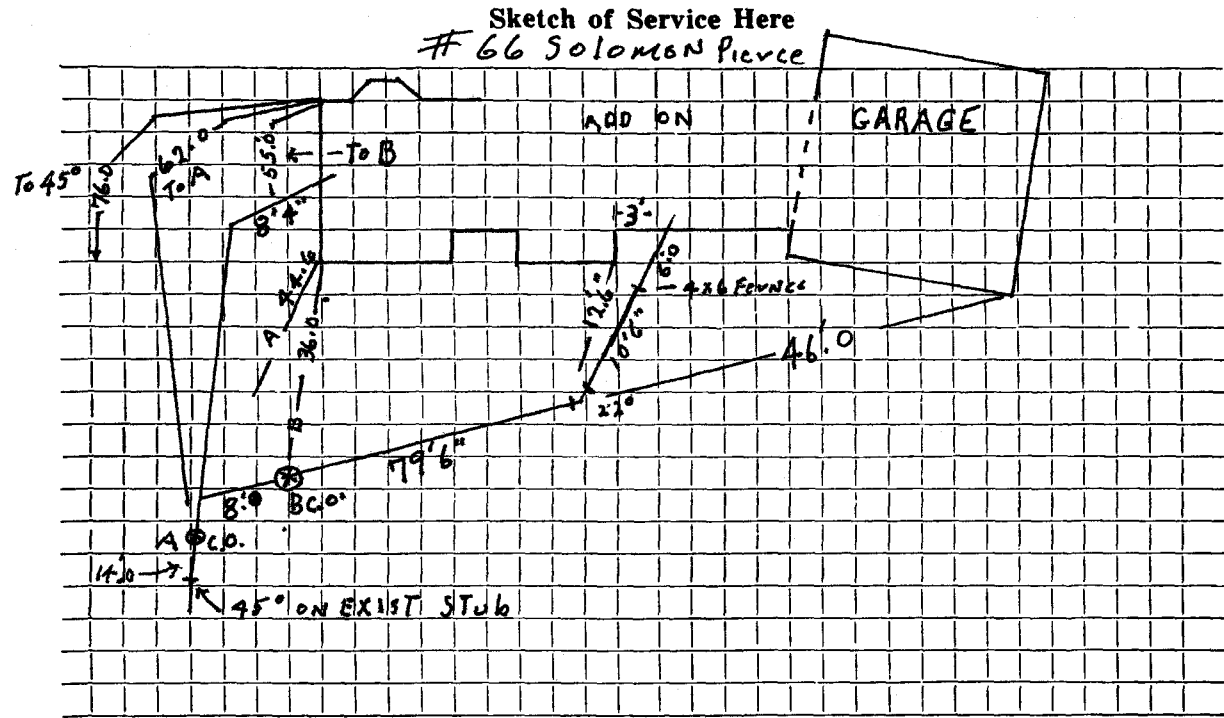

Connection made in ..... Street. Work completed .....

Remarks: 9.0" BETWEEN CLEANOUT A + B - 6" BELOW GRADE. INV. C.O. 7.0 DEEP

.....  
.....