

Name

Service No.

Address# 7 Soloman Pierce Rd.

7 Soloman Pierce Road

Location

Kind of Pipe PVC

Size

6"

Size of Main 8" PVC

Repair—Renewal (New Service)

Location

Date

Material

Amount

Total

Date

Amount

1986


① 22° bend
 ① 6" X 6" wye & cement
 ① 6" X 4" Fernco reducer
 96' 0" of 6" PVC.
 8' 0" x 4" "

35' 6" P.V.C.
 1 6" X 8" wye

DATE _____

TOWN OF LEXINGTON — BOARD OF PUBLIC WORKS SEWER DIVISION

Sketch of Service Here

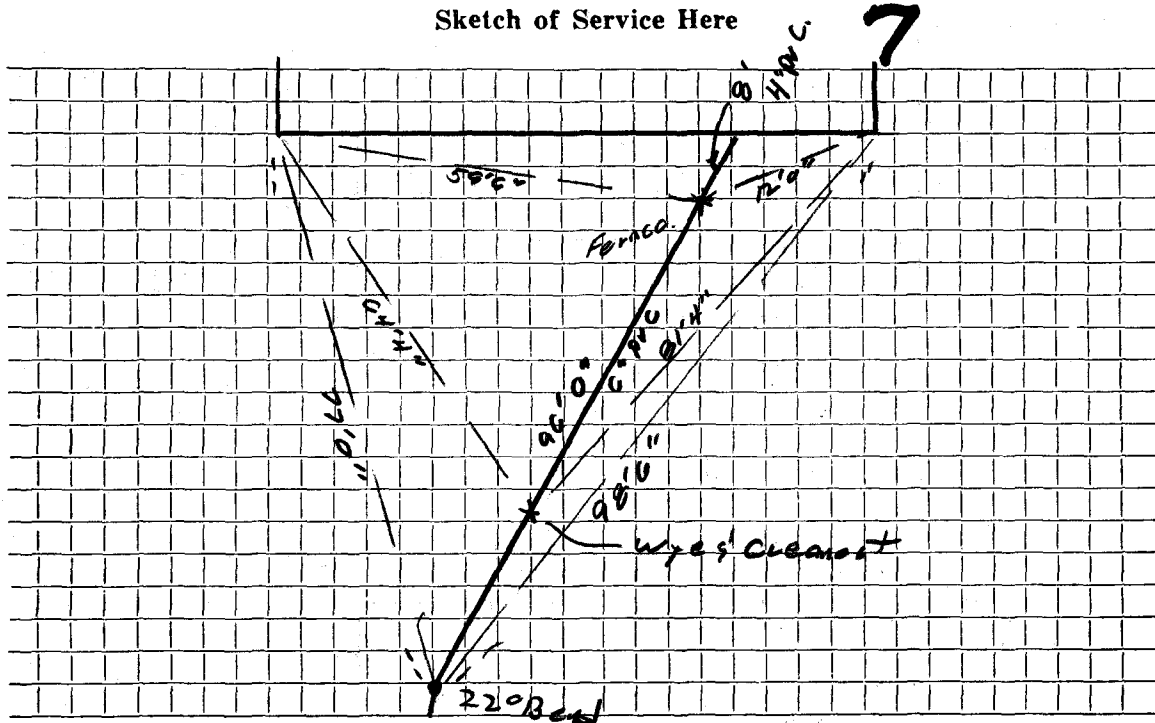

Connection made in Sakamon Pierce Rd Street.

Work completed

Remarks: