

Name Myles J. Holley Jr.

Service No. 104

Address 11 Somerset Road

11 Somerset Road

Location

Kind of Pipe

Size 6"

Size of Main 8"

~~Repair~~ Renewal ~~New Service~~ W.O. #9100

Location DEC 31 1970


Date	Material	Amount	Total	Date	Amount
11-17-70	Labor 79.52			11-23-70	360.00
1-19-70	" 53.08	132.60		1-18-71	98.99
	10% O.H.	13.26	145.86		261.01
49'	6" Transite pipe @.90		44.10		
1	Ring		2.65		
1/2	bag Cement		.90		
5	yds. Loam @3.50		17.50		
10	lbs. Seed @1.10		11.00		
5	lbs. Fertilizer		1.00		
4	hrs. Trucking @3.00		12.00		
4	hrs. Town Shovel @6.50		26.00		
			261.01		

DATE _____

TOWN OF LEXINGTON — BOARD OF PUBLIC WORKS

SEWER DIVISION

Sketch of Service Here

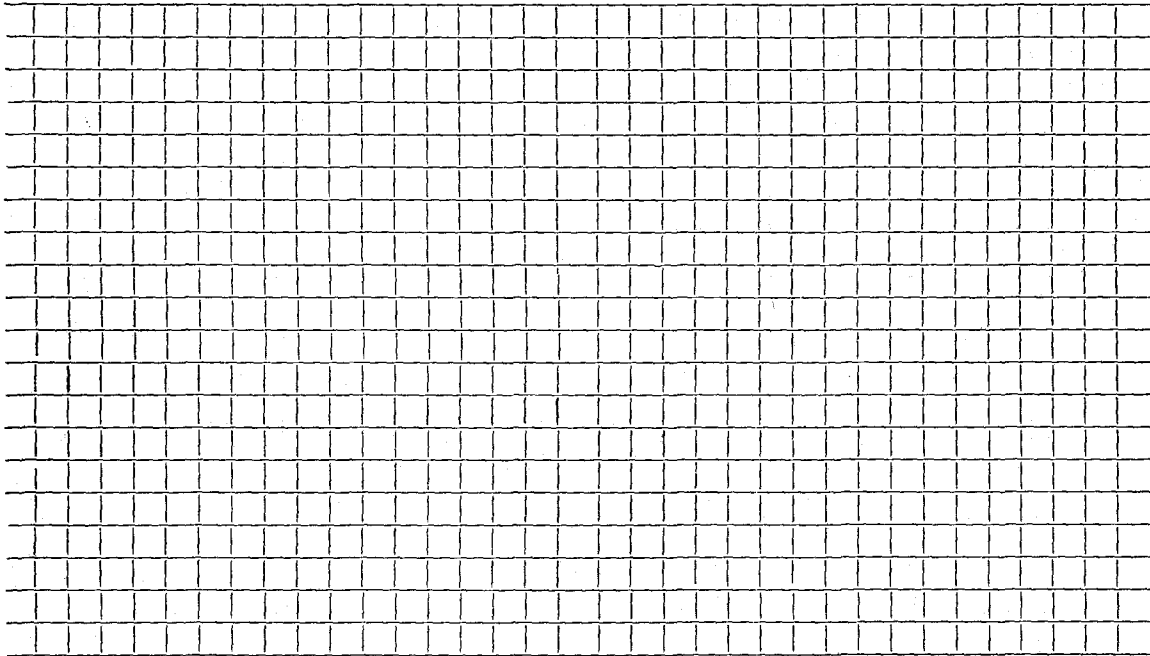

Connection made in Street. Work completed

Remarks: Original Service 8-26-57 (93'-6" Transite, 4-6" clay pipe,
1-6" Clay Elbow)