

Name Alan G. Adams

Service No. 165

Address 13 &amp; 15 Somerset Rd.

13 &amp; 15 Somerset Rd.

Location

Kind of Pipe

Size 6"

Size of Main 8"

Repair: ~~Renewal~~ - New Service

Committed 12-8-52

Location

Date	Material	Amount	Total	Date	Amount
11/7/52	Labor	23 78		11-7-52 Deposited *12-8-52 Refunded	25 00 32 77
	10% Overhead	2 38	26 16		NON CHARGE 92 23
	52' - 6" sewer pipe@.342		17 78	11/7/52 Labor	20 00
	Joint compound		3 12	44' - 6" sewer pipe@.342	15 05
	4 2/3 hrs. Littlefield shovel@.7	32 67		joint compound	2 64
	2 hrs. trucking @ .75		1 50	4 hrs. Littlefield shovel@.7	28 00
	patching 11 X 3		11 00	2 hrs. trucking @.75	1 50
			92 23	patching 16 X 3	16 00
5/6/96	DAVE SANTO INSP. ENGR.				83 19
	PVC House To BACK EDGE RD				
	Water/same Trench			*4 21.69 made payable to L. of City and applied to W.D.O. #326	
	Labor			# 9.11 applied to S.W.C. #86	
	(No Rooting pipe in str.)				

TOWN OF LEXINGTON—DEPT. OF PUBLIC WORKS  
**SEWER DIVISION**

DATE .....

NO. ....

The undersigned applies for the construction of a particular sewer connecting No. ....  
Street and hereby agrees to comply with the Rules and Regulations governing the construction and use of Particular  
Sewers, as now or at any future time established by the Board of Selectmen.


Am't of estimate \$.....

Am't Paid \$.....

..... Owner

Sketch of Service Here

15

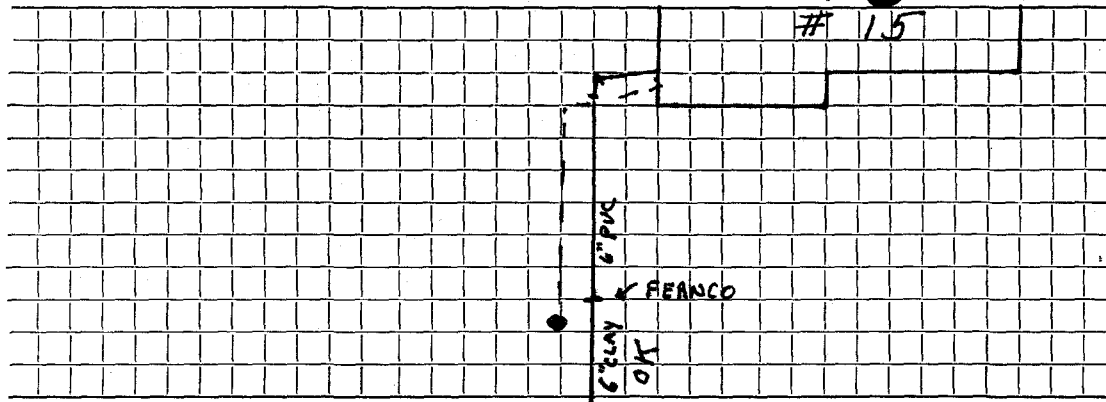

Connection made in SOMERSET WATER IN SAME TRENCH Street.

Work completed ..... 19..

Remarks: PUT NEW COPPER CURB TO OUTSIDE HOUSE