

Name Louis Stoico

Service No. 180

Address 23 Somerset Road

23 Somerset Road

Location

Kind of Pipe

Size 6"

Size of Main 8"

~~Repair - Renewal~~ New Service WO #7708

Location Comm 1-14-63

Date	Material	Amount	Total	Date	Amount
11-20-62	Labor	21.00		11-5-63	256.00
11-21-62	"	87.28	108.28	1-14-63	48.5
	10% O.H.	10.83	119.11		245.15
	73' 6" Transite pipe @.82		59.86		
	2 11 ¹⁰ / ₄ Transite Bends @4.09		8.18		
	6 hrs. Town Shovel @6.50		39.00		
	3 hrs. Trucking @3.00		9.00		
	2 hrs. Loader @5.00		10.00		
			245.15		


DATE _____

TOWN OF LEXINGTON — BOARD OF PUBLIC WORKS

SEWER DIVISION

Sketch of Service Here

23

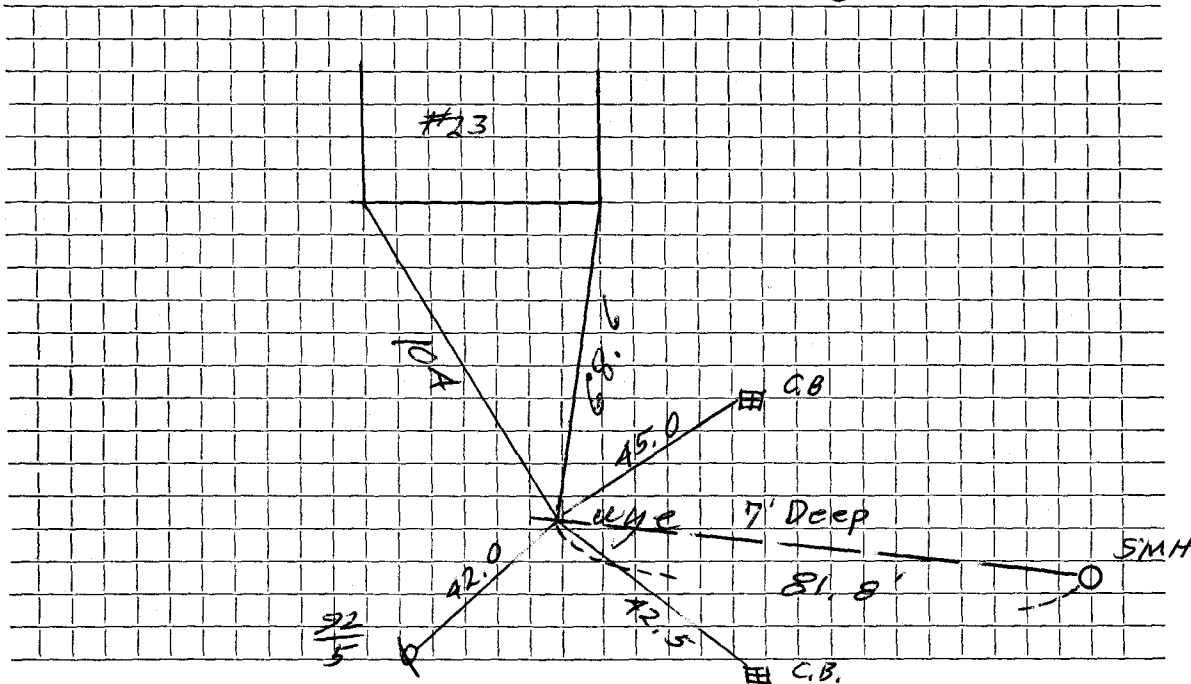

Connection made in Street. Work completed

Remarks:
.....
.....