




DATE \_\_\_\_\_

TOWN OF LEXINGTON — BOARD OF PUBLIC WORKS  
SEWER DIVISION

Sketch of Service Here

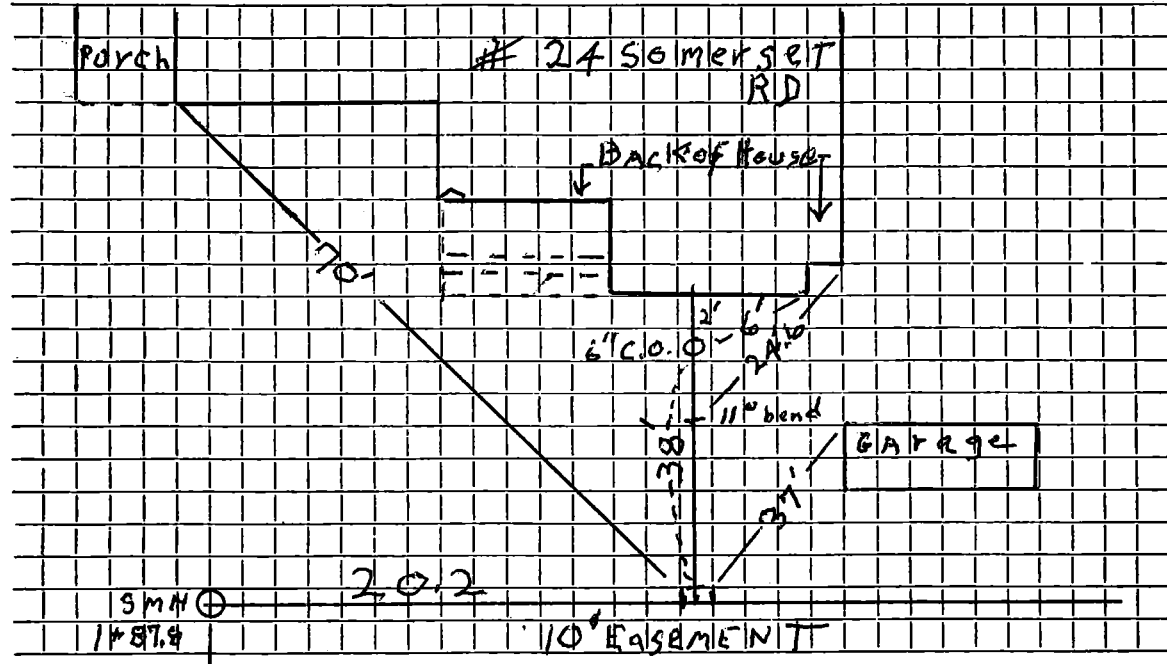

Connection made in ..... Street. Work completed 11/29/11 Dave. Santa.....

Remarks: C.O. To 11\'' bend 21' .....

.....  
.....