

Name Michael Scott Morton

Service No. 40

Address 31 Somerset Rd.

31 Somerset Road

Location

AUG 6 1979

Kind of Pipe

Size 6"

Size of Main 8"

~~Repair~~—Renewal—~~New Service~~

W.O. # 0511


Location

Date	Material	Amount	Total	Date	Amount
6/15/79	Labor	105. 32		6-14-79	200.00
	10% O.H.	10. 53	115. 85	9-2-79	43.67
	40' 6" Transite @ 1.91		76. 40		243.67
	1 6" Trans to Clay Adapter		6.42		
	6 Ton Fine Gravel @ 2.25		13. 50		
	4 Hrs. Trucking @ 3.00		12. 00		
	3 Hrs. Backhoe @ 6.50		19. 50		
			\$ 243. 67		
10/20/84	30' x 6" PVC				
	1 6" x 4" Donut				
	1 6" PVC Cap				

DATE \_\_\_\_\_

TOWN OF LEXINGTON — BOARD OF PUBLIC WORKS  
SEWER DIVISION

Sketch of Service Here **31**

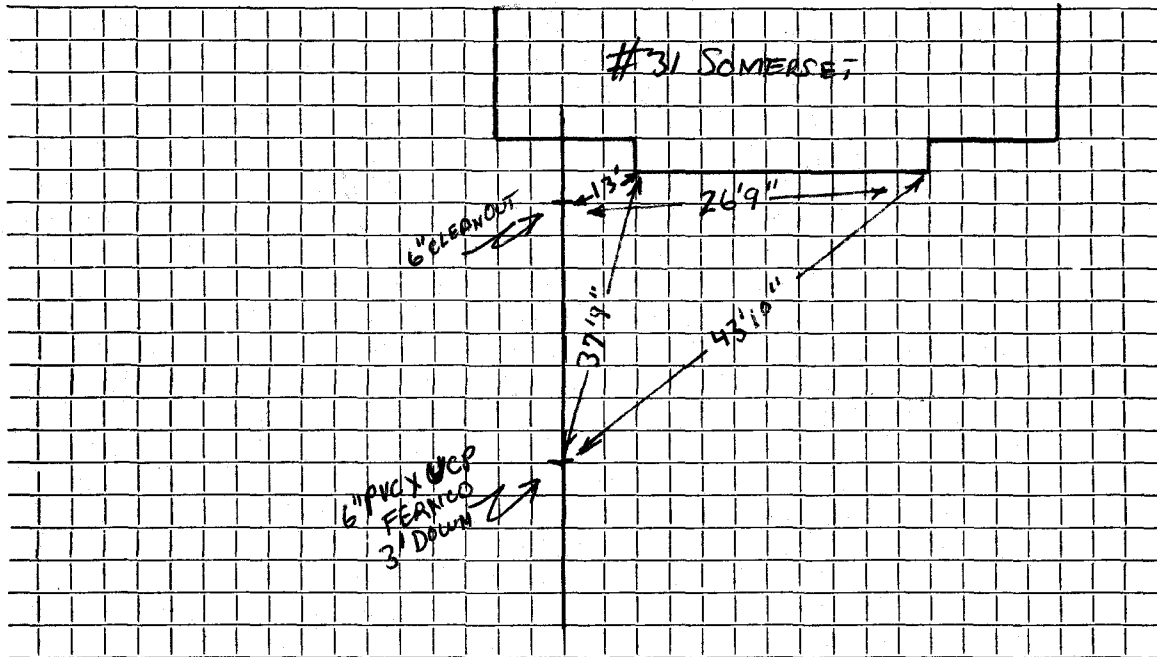

Connection made in ..... Street. Work completed .....

Remarks: .....

.....  
.....