


DATE July 1980

TOWN OF LEXINGTON — BOARD OF PUBLIC WORKS

SEWER DIVISION

Sketch of Service Here **41**

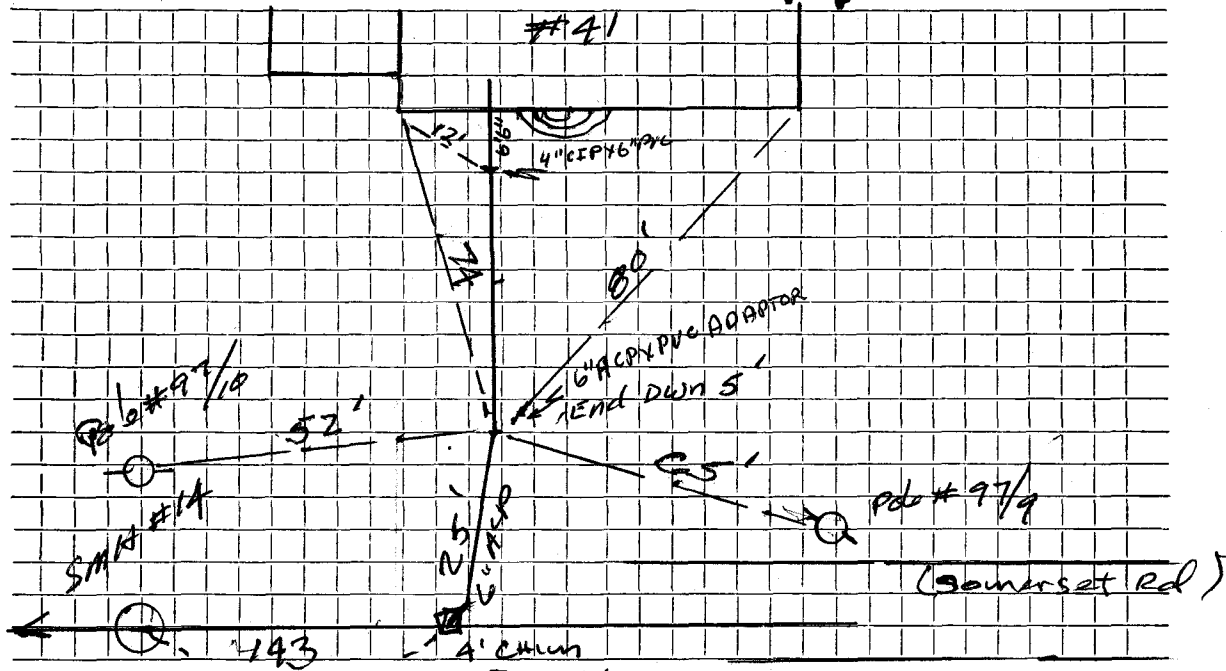

Connection made in somerset Rd. Street. Work completed Oct. 24, 1984.....

Remarks:

.....

.....