

Name *Wilber Jaquith*

Service No.

Address *42 Somerset Rd.*

42 Somerset Road

Location

Kind of Pipe

Size **6"**

Size of Main **8"**

Repair—Renewal—New Service ✓ *Dave Eagle #2002*


Location

Date	Material	Amount	Total	Date	Amount
<i>8-18-72</i>	<i>47' - 6" ACP</i>				
	<i>12' - 4" CI</i>				

DATE _____

TOWN OF LEXINGTON — BOARD OF PUBLIC WORKS
SEWER DIVISION

Sketch of Service Here **42**

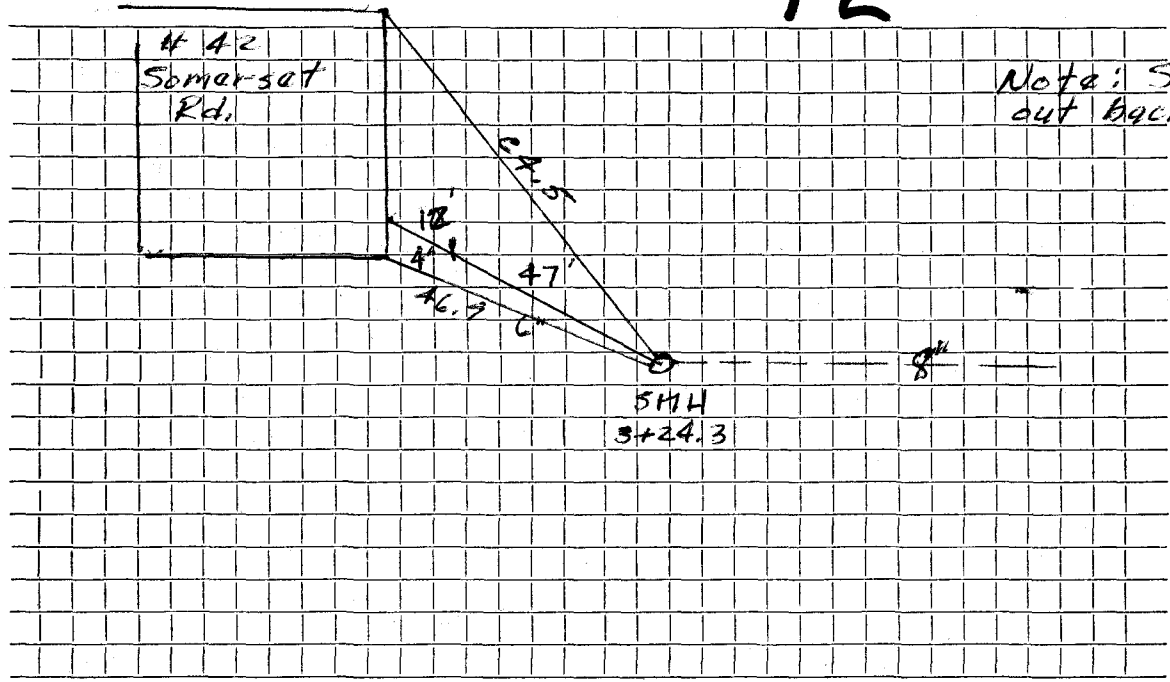

Connection made in Street. Work completed

Remarks: *Connected in easement out back*
.....
.....