




DATE \_\_\_\_\_

TOWN OF LEXINGTON — BOARD OF PUBLIC WORKS

SEWER DIVISION

Sketch of Service Here **43**

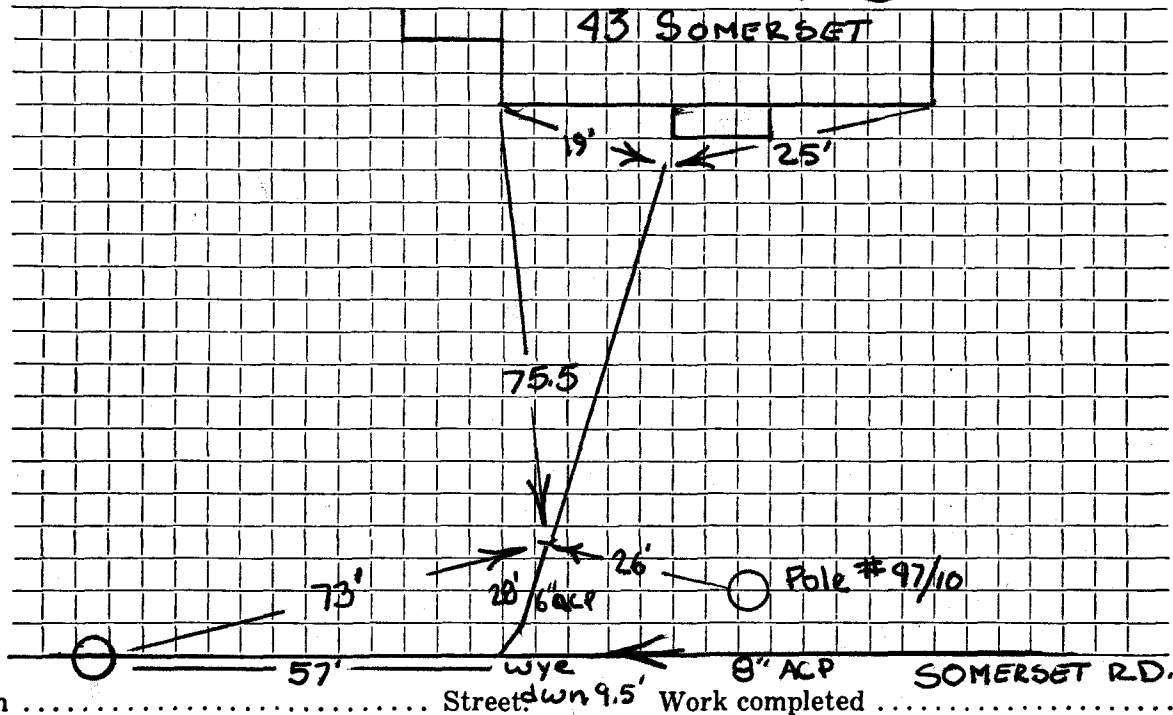

Connection made in ..... Street: ..... Work completed .....

Remarks: .....

.....