




DATE \_\_\_\_\_

TOWN OF LEXINGTON — BOARD OF PUBLIC WORKS

SEWER DIVISION

Sketch of Service Here

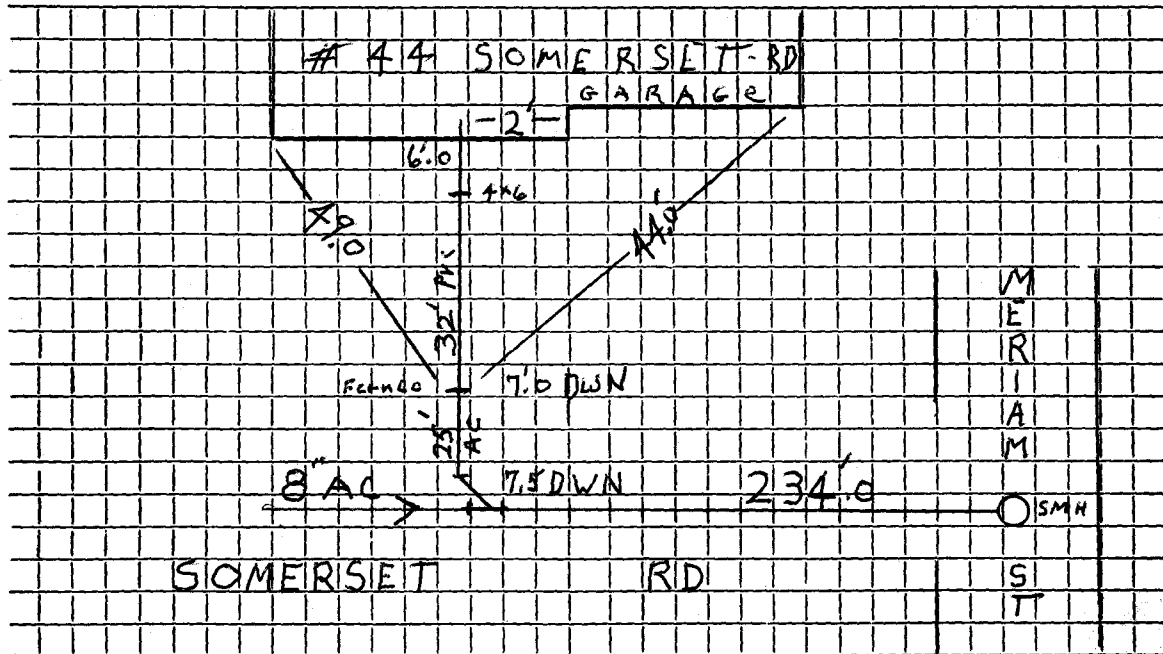

Connection made in ..... Street.

Work completed 6/9/07 J. McLaughlin.....

Remarks: .....

.....

.....