

Name Gordon Richards

Service No. 2

Address 49 Somerset Road

Lexington, Mass.

Location 49 Somerset Road

Kind of Pipe

Size 6"

Size of Main 8"

~~XXXXXXXXXX~~ New Service

Com. 5-2-49

Location

Date	Material	Amount	Total	Date	Amount
Jan. 11, '49	Labor	50 28		June 10 '49	175 00
	10% Overhead	5 03	55 31	May 5 '49	12 25
	72' - 6" Sewer Pipe @.26		18 72		162 35
	Joint Compound		4 32		
	Littlefield Shovel 8 hrs. @7.00		56 00		
	Compressor 2 hrs. @ 1.75		3 50		
	Patching 23 x 3		23 00		
	Trucking 2 hrs. @.75		1 50		
			162 35		
	Labor				

TOWN OF LEXINGTON—DEPT. OF PUBLIC WORKS  
**SEWER DIVISION**

DATE .....

NO. ....

The undersigned applies for the construction of a particular sewer connecting No. ....  
Street and hereby agrees to comply with the Rules and Regulations governing the construction and use of Particular  
Sewers, as now or at any future time established by the Board of Selectmen.

Am't of estimate \$. ....


Am't Paid \$. ....

..... Owner

---

---

**Sketch of Service Here**

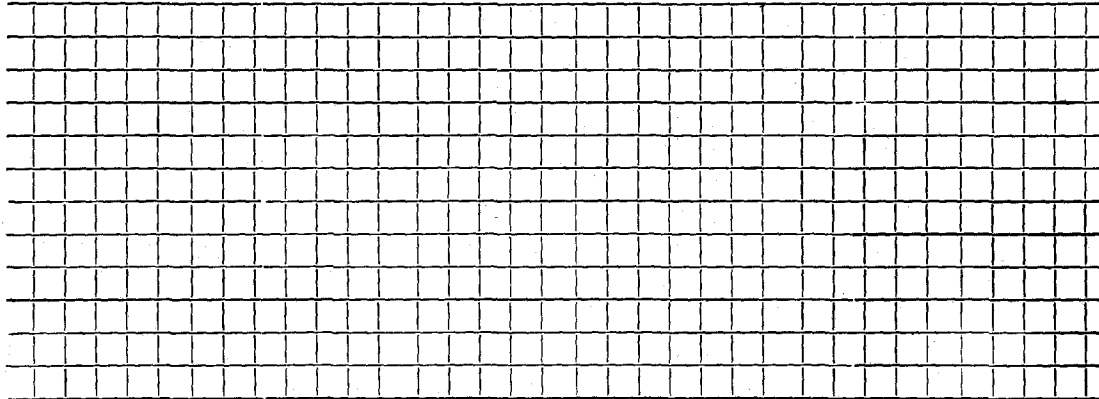

Connection made in ..... Street.

Work completed ..... 19..

Remarks: