

Name

Service No.

Address #11 South Rindge Ave.

11 S. Rindge Ave

Location

Lot 11

Kind of Pipe

PVC

Size

6"

Size of Main

8"

Repair—Renewal—New Service

Location

Date	Material	Amount	Total	Date	Amount
------	----------	--------	-------	------	--------


1985	1536' of 6" PVC.	No. C.			
------	------------------	--------	--	--	--

DATE _____

TOWN OF LEXINGTON — BOARD OF PUBLIC WORKS
SEWER DIVISION

Sketch of Service Here

LOT 11

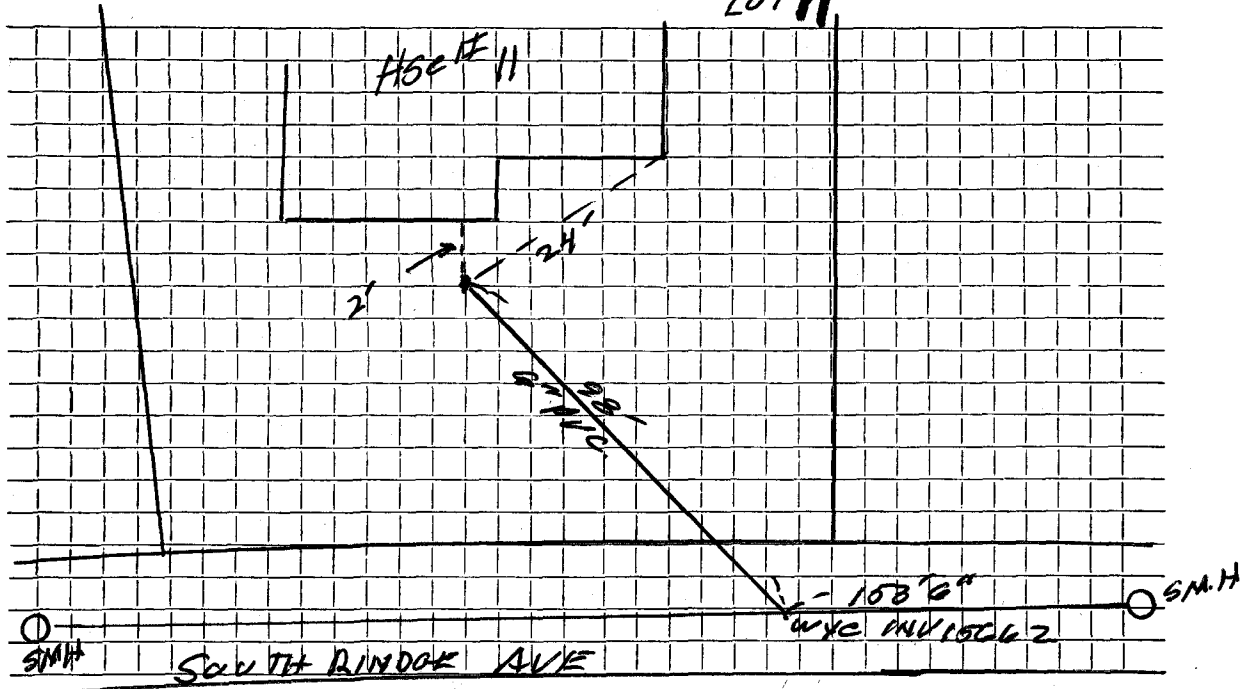

Connection made in Street. Work completed

Remarks:

.....

.....