

Name

Service No.

Address #15 South Rindge Ave.

15 S. Rindge Ave.

Location

lot 12<sup>f</sup>

Kind of Pipe

PVC

Size

6"

Size of Main

8"

Repair—Renewal—New Service

Location

Date

Material

Amount

Total

Date

Amount

1985

69' of 6" PVC.  
① 22 1/2 bend.


N/C

DATE \_\_\_\_\_

TOWN OF LEXINGTON — BOARD OF PUBLIC WORKS  
SEWER DIVISION

Sketch of Service Here

15 LOT #2

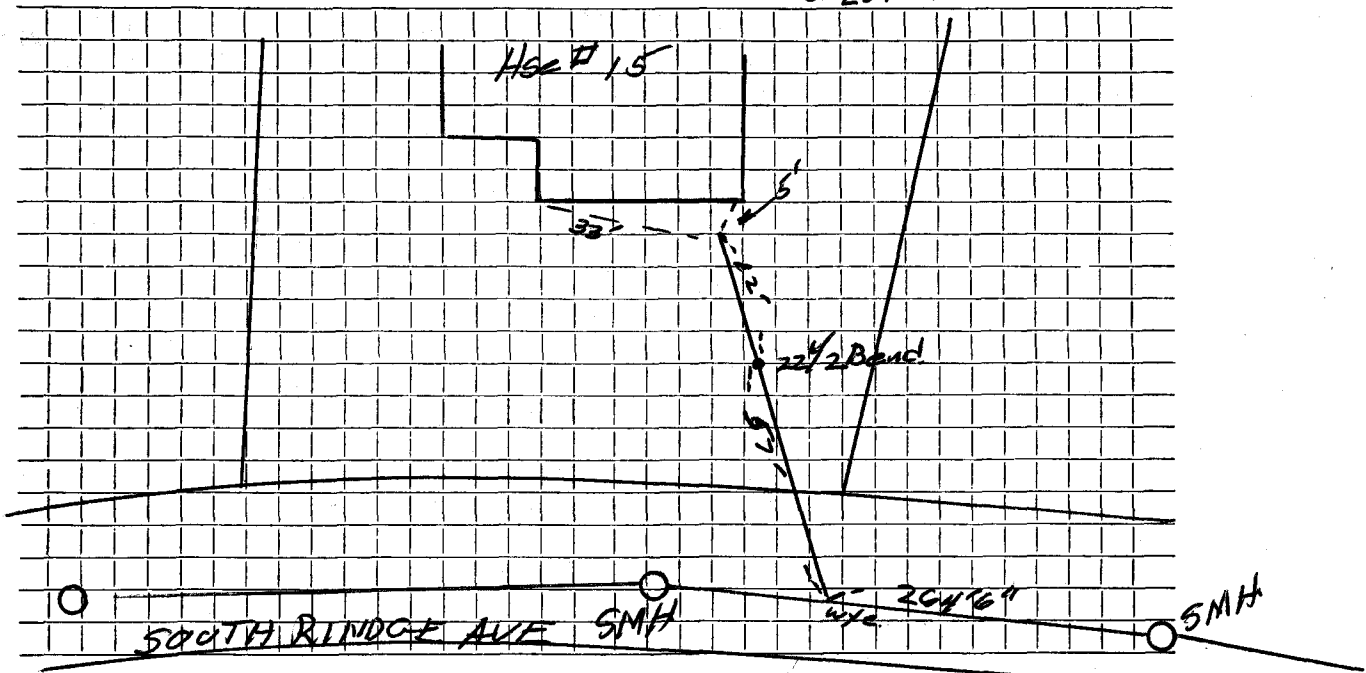

Connection made in ..... Street. Work completed .....

Remarks: .....

.....

.....