




DATE \_\_\_\_\_

TOWN OF LEXINGTON — BOARD OF PUBLIC WORKS

SEWER DIVISION

Sketch of Service Here

LOT 16

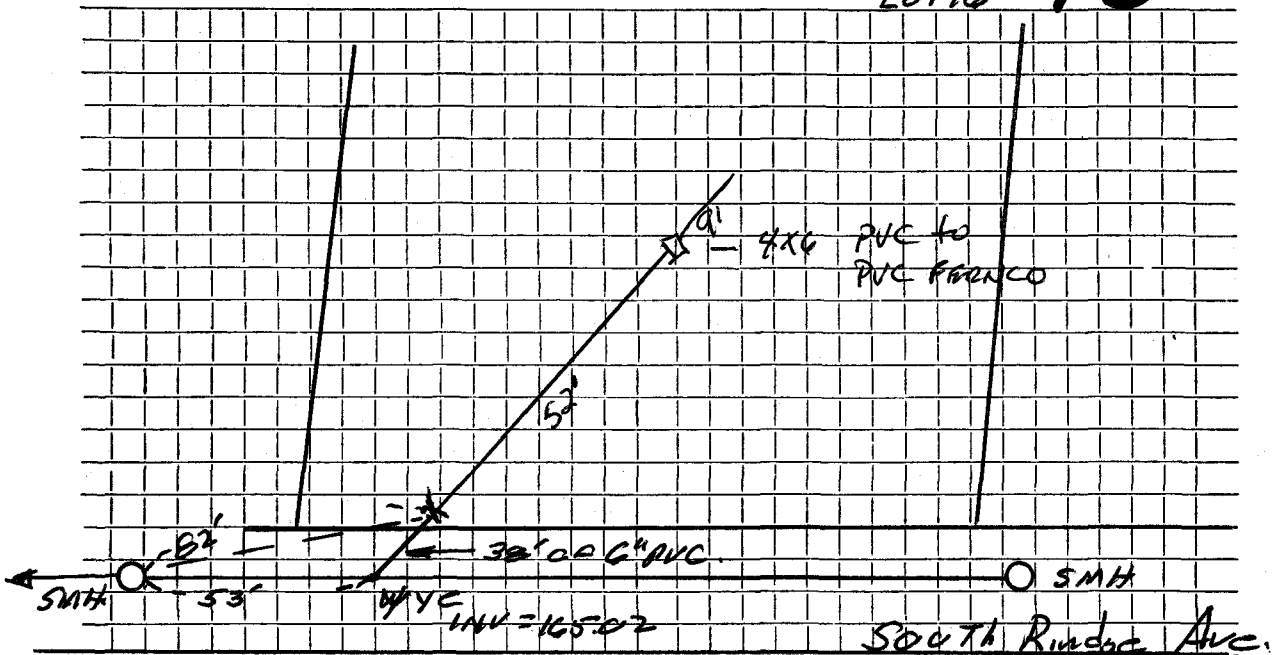

Connection made in SOUTH RINDGE Street. Work completed .....

Remarks: INSIDE installed MAR 18, 1999