

Name

Service No.

Address #18 South Rindge Ave.

18 S. Rindge Ave.

Location

lot 15

Kind of Pipe

PVC

Size

6"

Size of Main

8"

Repair—Renewal—New Service

Location

Date

Material

Amount

Total

Date

Amount

1985


113'6" of 6" PVC

N/C

DATE _____

TOWN OF LEXINGTON — BOARD OF PUBLIC WORKS
SEWER DIVISION

Sketch of Service Here **18**

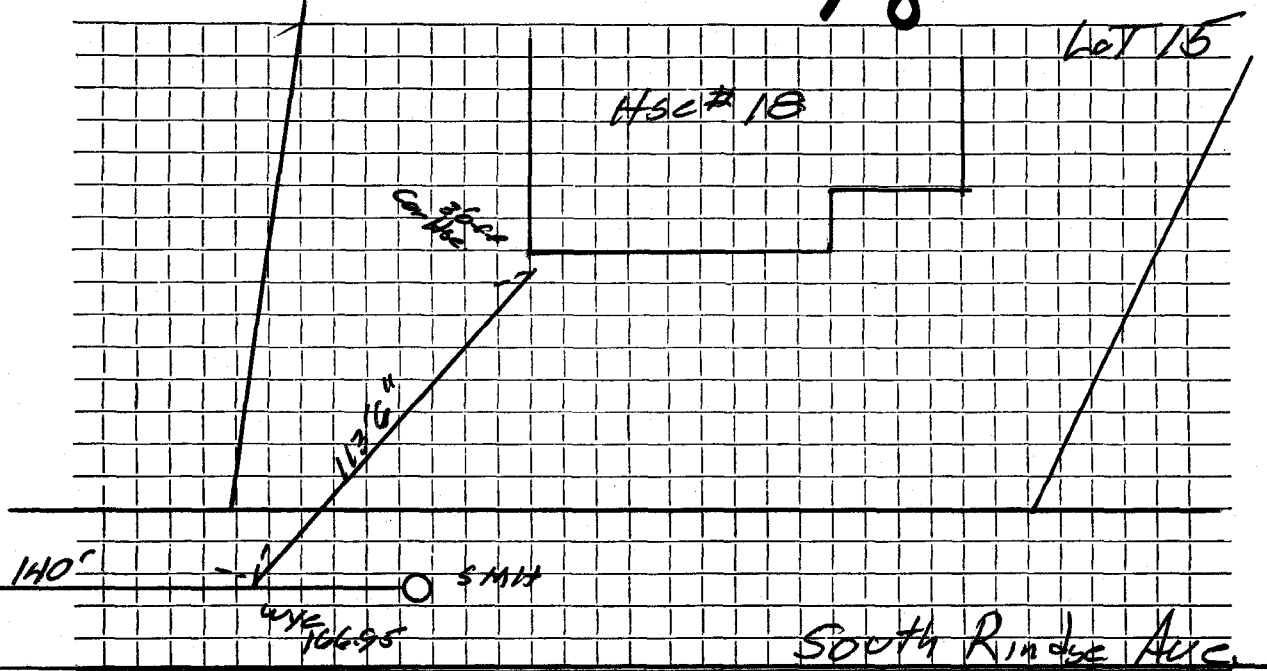

Connection made in Street. Work completed

Remarks:

.....

.....