

Name

Service No.

Address # 19 South Rindge Ave.

19 S. Rindge Ave.

Location

lot 14

Kind of Pipe

PVC

Size

6" <sup>CL</sup>

Size of Main

8"

Repair—Renewal—New Service

Location

Date

Material

Amount

Total

Date

Amount

1985

77'6" of 6" PVC

N/C


(2) 22 1/2 bends

DATE \_\_\_\_\_

TOWN OF LEXINGTON — BOARD OF PUBLIC WORKS

SEWER DIVISION

Sketch of Service Here **19** Lot 14

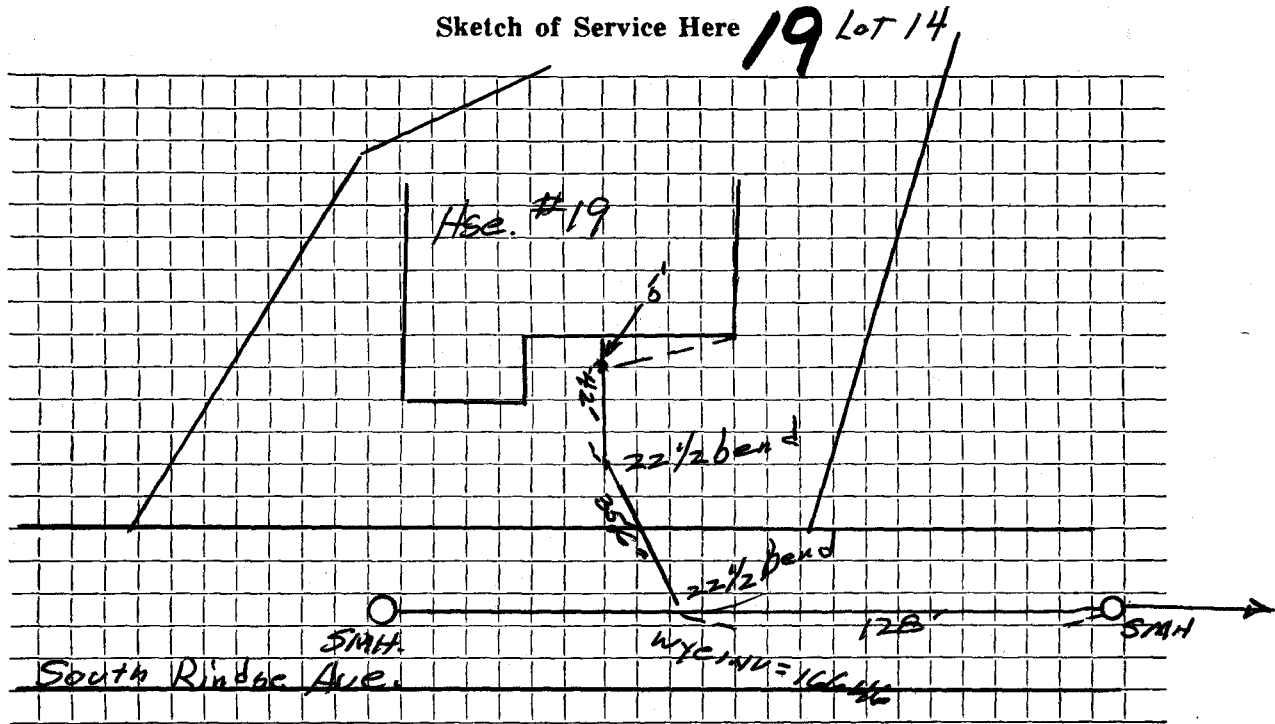

Connection made in ..... Street. Work completed .....

Remarks: .....  
.....  
.....