

三

Services

**Address:** 4 South Ridge Ave.

Address

4 S. Ridge Ave.

Location

### Kind of Pipe

Size of Main 8"

## **Repair—Renewal—New Service**

## Data Material

Army Inv.

Total

A  
10

הנִזְקָנָה

1180

103

1018

3326

四

- 1 -


DATE

**TOWN OF LEXINGTON — BOARD OF PUBLIC WORKS**

**SEWER DIVISION**

### **Sketch of Service Here**

4

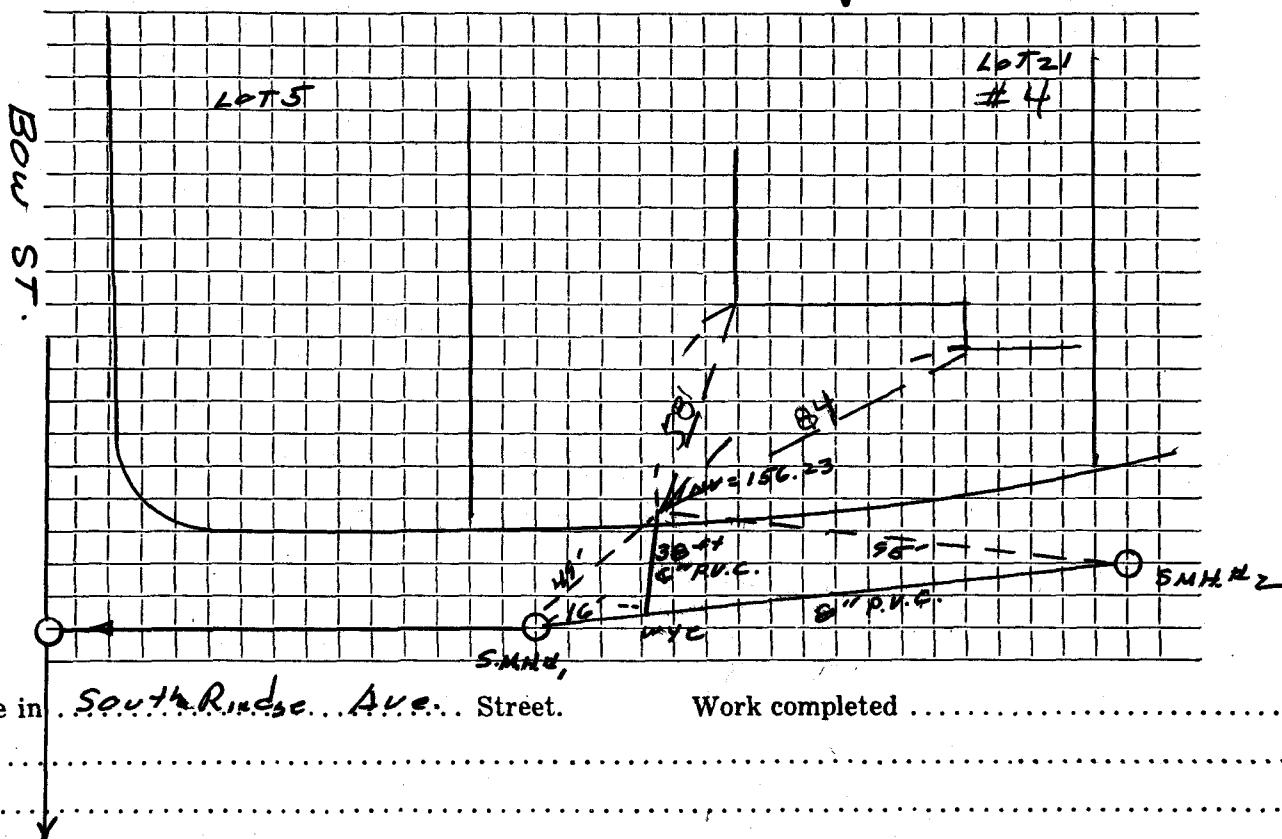

Connection made in South Ridge Ave. Street.

### **Work completed . . . . .**

**Remarks:** \_\_\_\_\_