




DATE \_\_\_\_\_

# TOWN OF LEXINGTON — BOARD OF PUBLIC WORKS

## SEWER DIVISION

Sketch of Service Here

5

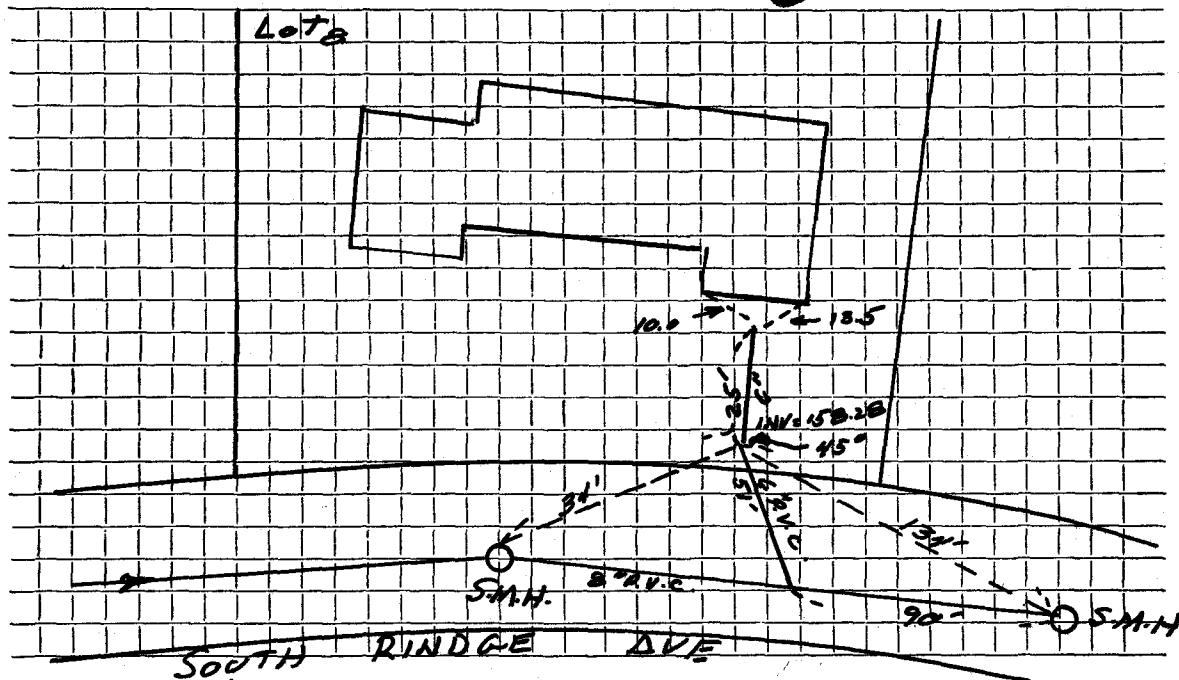

Connection made in South Rindge Ave Street. Work completed .....

Remarks: .....

.....

.....