

Name John W. Flaherty

Service No.

1091

Address 4 Spencer Street

Lexington, Mass.

Location 4 Spencer Street

Kind of Pipe

Size 6"

Size of Main 8"

~~Repair/Renewal~~ - New Service

Location

Date	Material	Amount	Total	Date		Amount
May 8, '47	Labor	44 03	44 03	May 6 '47	Deposited	110 00
	10% Overhead		4 40	Nov. 29 '47	Refunded	44 20
	32' - 6" Sewer Pipe @ .26		8 32			65 30
	1 - 6" Elbow		1 28			
	Joint Compound		1 92			
	Cement, 2 bags @ 1.05		2 10			
	Compressor 1 hr. @ 1.75		1 75			
	Trucking 2 hrs. @ .75		1 50			
			65 30			
	Com 11-21-47					
	Labor					

# TOWN OF LEXINGTON—DEPT. OF PUBLIC WORKS

## SEWER DIVISION

DATE .....

NO. ....


The undersigned applies for the construction of a particular sewer connecting No. .... Street and hereby agrees to comply with the Rules and Regulations governing the construction and use of Particular Sewers, as now or at any future time established by the Board of Selectmen.

Am't of estimate \$.....

Am't Paid \$.....

..... Owner

Sketch of Service Here **4**

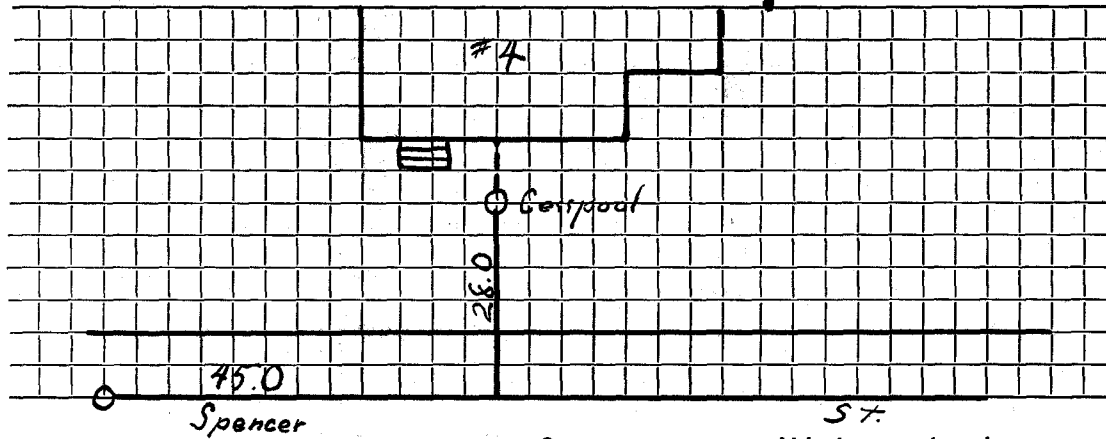

Connection made in ..... Street.

Work completed ..... 19..

Remarks: