

Name Agnes Walton

Service No. 13

Address 5 Spencer Street

Lexington, Mass.

Location 5 Spencer Street

Kind of Pipe

Size 6"

Size of Main 8"

~~Repair~~ New Service Com. 7-3-50

Location

Date	Material	Amount	Total	Date	Amount
May 12, '47	Labor	29 13	29 13	April 28 '50	100 00
	10% Overhead		2 91	July 20 '50	4 07
	20' - 6" Sewer Pipe @.26		5 20	5-12-47	95 93
	1 - 6" 1/8 Bend		1 28	20' 6" Sewer Pipe	
	Joint Compound		1 20	1 6"-1/8 Bend	
	Trucking 1 hr. @.75		75		
			40 47		
May 15, '50	Labor	35 27	35 27		
	10% Overhead		3 53		
	24' - 6" Sewer Pipe @.28		6 72		
	Joint Compound		1 44		
	Littlefield Shovel 1 hr. @7.00		7 00		
	Labor Trucking 2 hrs. @.75		1 50		
			55 46	95 93	

TOWN OF LEXINGTON—DEPT. OF PUBLIC WORKS
SEWER DIVISION

DATE

NO.


The undersigned applies for the construction of a particular sewer connecting No.
Street and hereby agrees to comply with the Rules and Regulations governing the construction and use of Particular
Sewers, as now or at any future time established by the Board of Selectmen.

Am't of estimate \$.....

Am't Paid \$.....

..... Owner

Sketch of Service Here

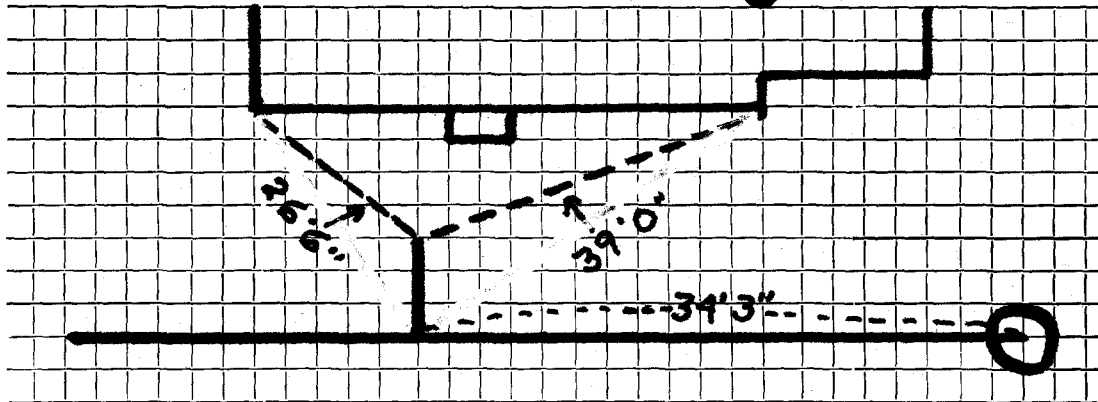

Connection made in Street.

Work completed 19..

Remarks: